


T. 10 S. R. 1 E. W. M.

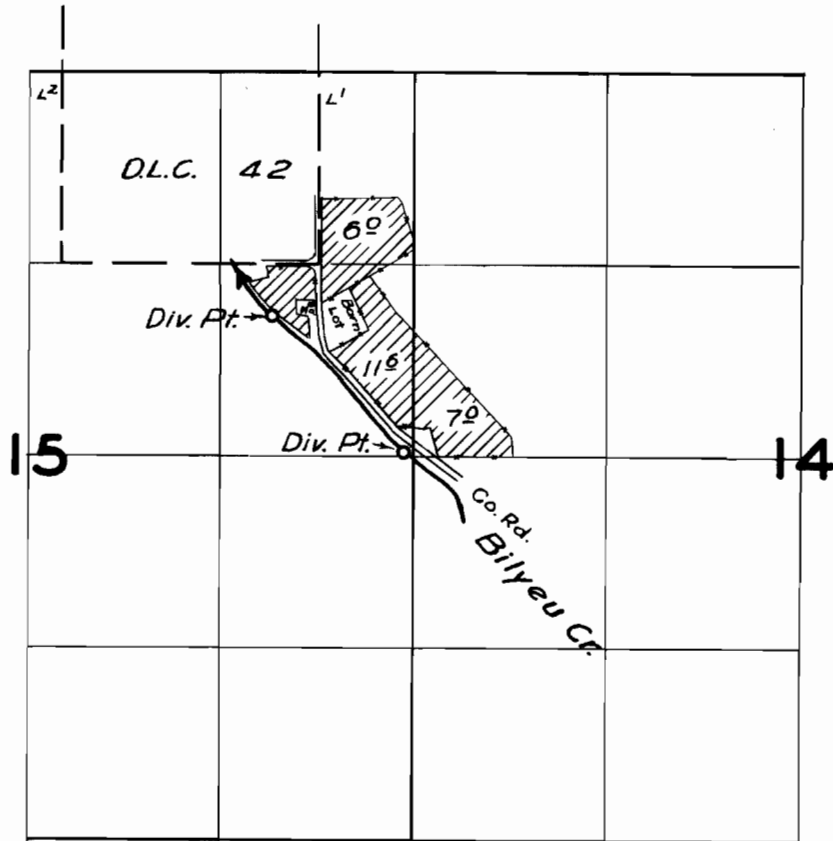

FINAL PROOF SURVEY

UNDER

Application No. 26233 Permit No. 20446

IN NAME OF

M. J. Gerard

Surveyed May 31, 1957, by M. Besh