


T. 4N. R. 28 & 29E. W.M.

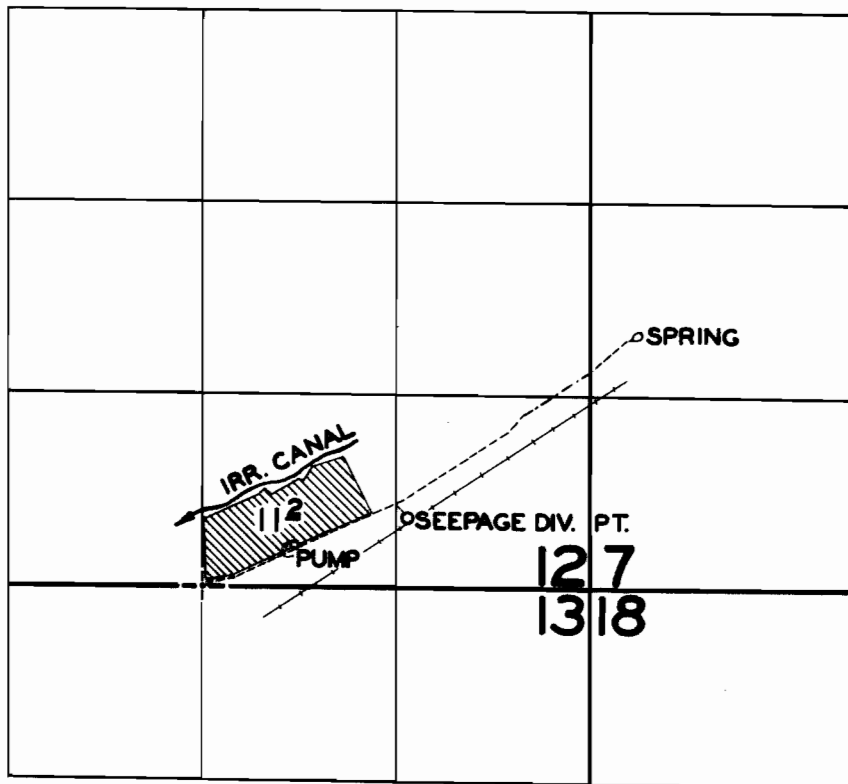

FINAL PROOF SURVEY

UNDER

Application No. 26051... Permit No. 20388.

IN NAME OF

.....WILMER MOORE.....

Surveyed MAY 15, 1957., by *C.O. [Signature]*