


# T.2&3N.R.9W.W.M.

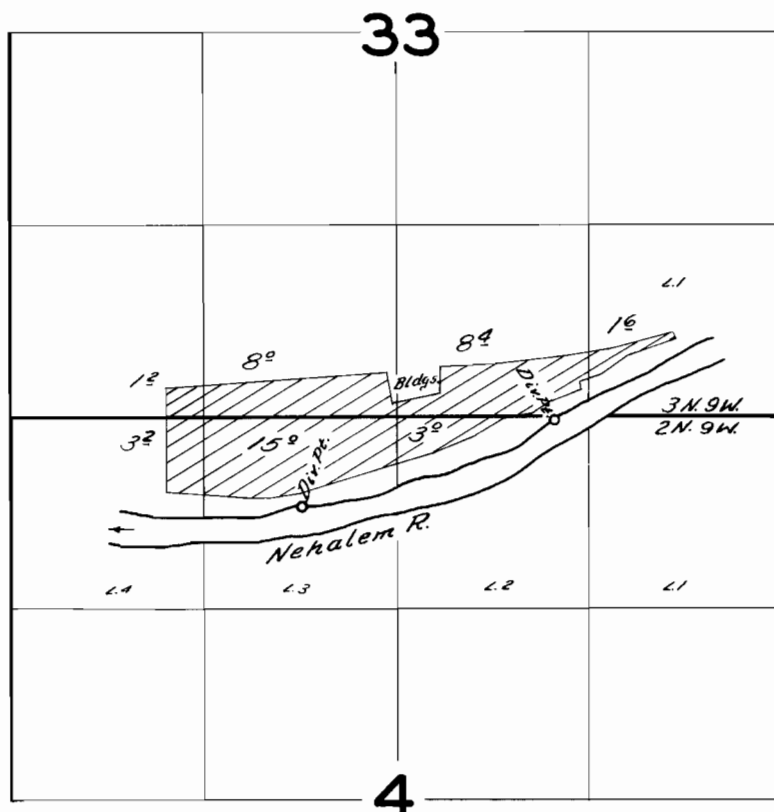

## FINAL PROOF SURVEY UNDER

Application No. 26262.. Permit No. 20613..  
IN NAME OF

*John J. Grimes*

Surveyed *Sept. 14, 1957*, by *C. O. Bantle*