


T.26 S.R.6 W.W.M.

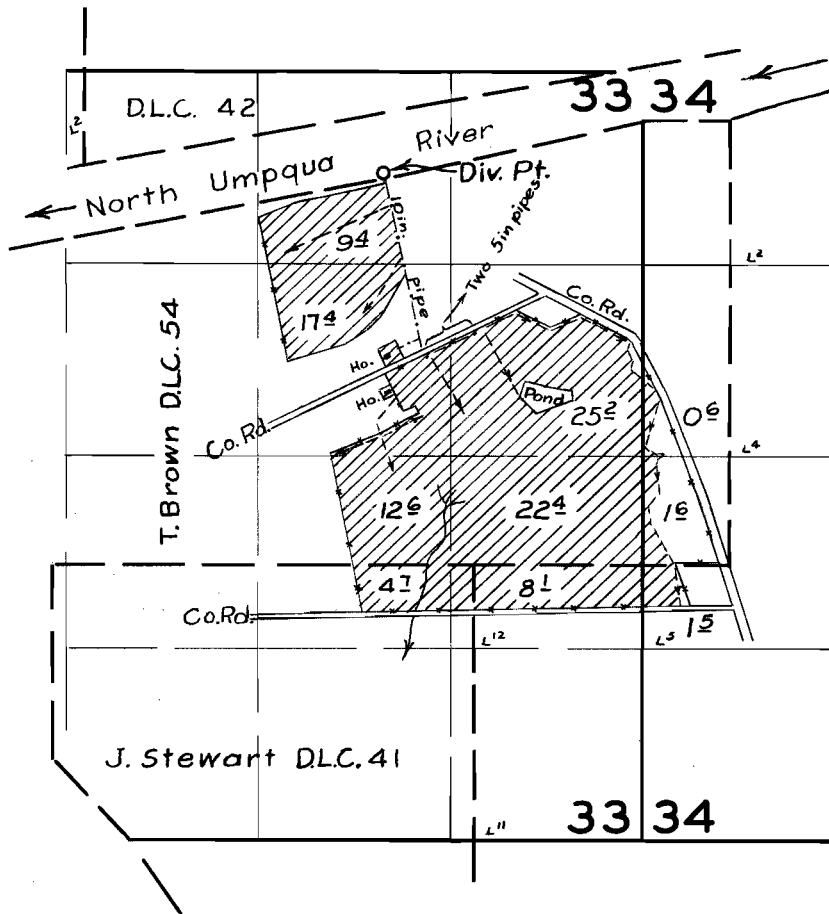

FINAL PROOF SURVEY UNDER

Application No. 26474. Permit No. 20752.
IN NAME OF

..... R. L. Harmon

Surveyed Sept. 5, 1957, by *M. Bish*