


T.17S.R.6W.W.M.

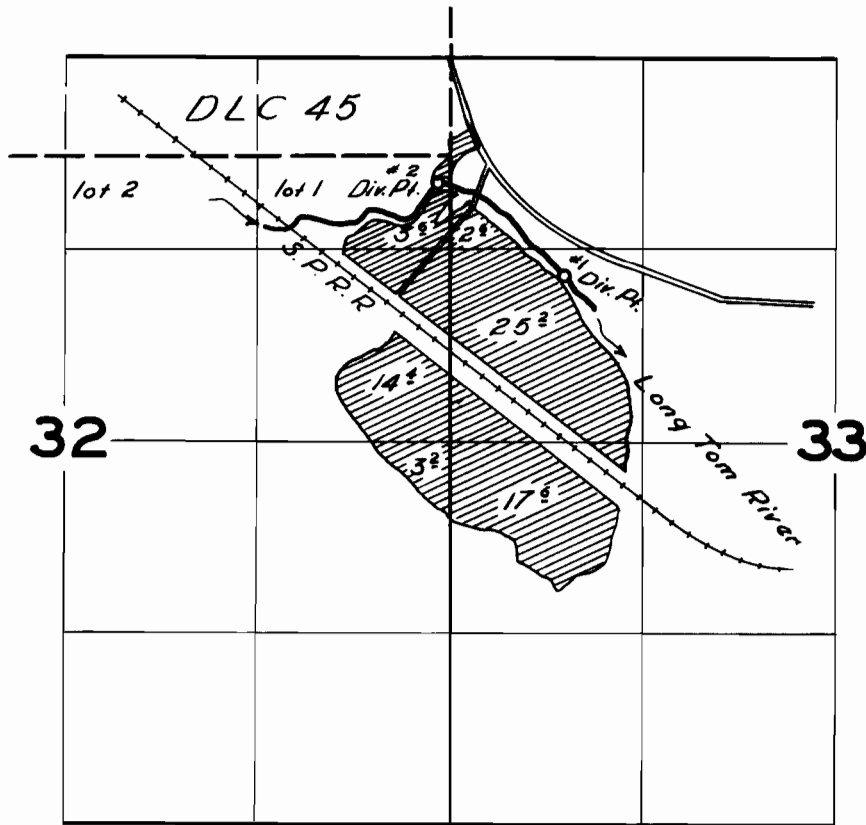

FINAL PROOF SURVEY

UNDER

Application No. 26494 Permit No. 20765

IN NAME OF

M. D. RIETMAN

Surveyed 3 May 1957, by [Signature]