


T. 6S. R. 1E. W.M.

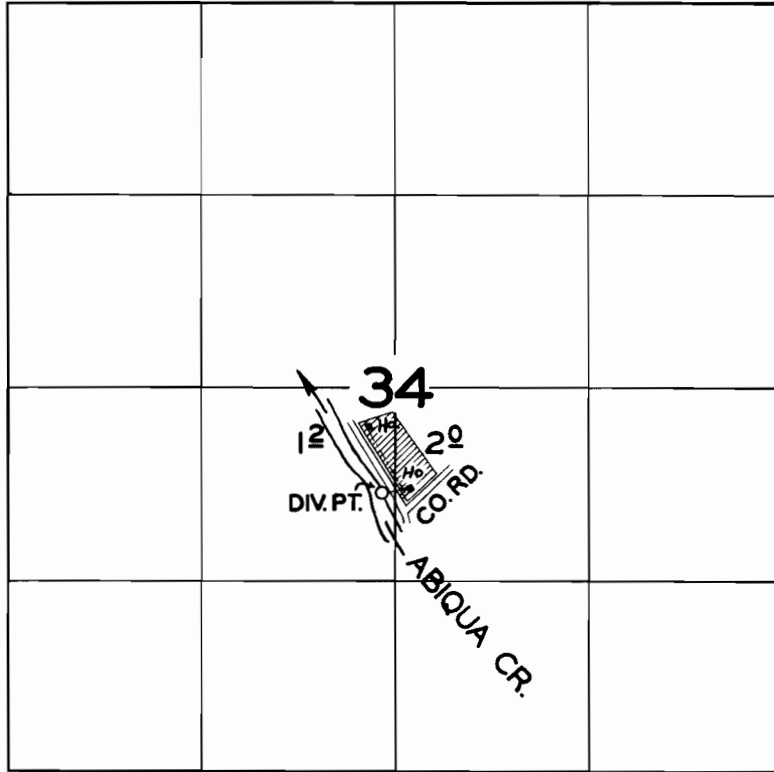

FINAL PROOF SURVEY
UNDER

Application No. 26568 Permit No. 20816
IN NAME OF

J. C. STROM & SON

Surveyed SEPT. 6, 1957, by C. O. Bartels