


T. 1 S. R. 9 W. W. M.

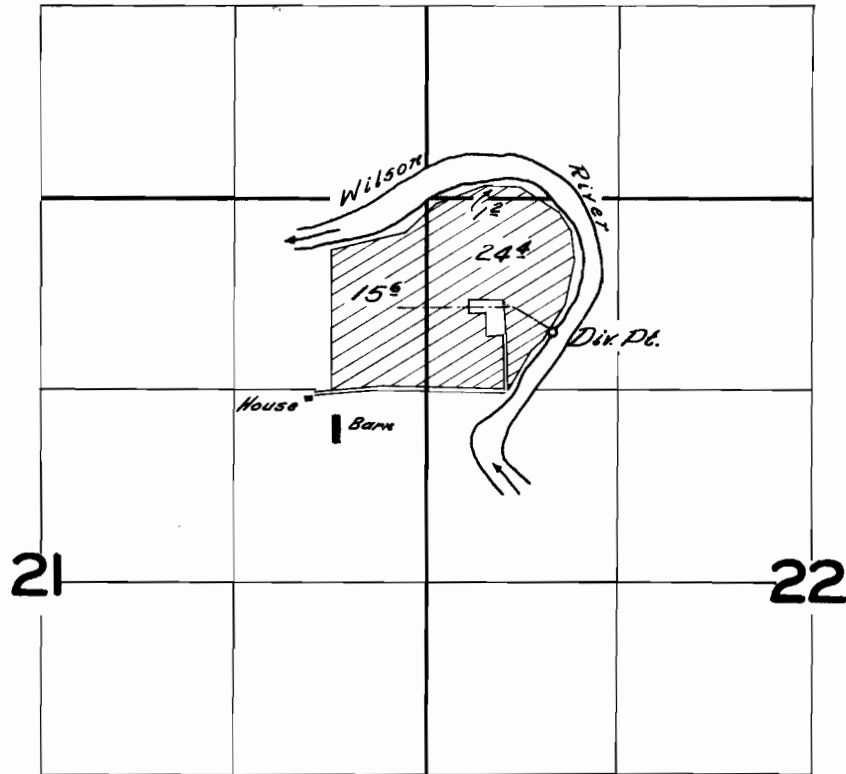

FINAL PROOF SURVEY UNDER

Application No. 26677. Permit No. 20889
IN NAME OF

Jack R. & Ella F. Caulfield

Surveyed *Sept. 12* 1957, by *C. O. Bartels*