


T. 6 S. R. 3 W. W. M.

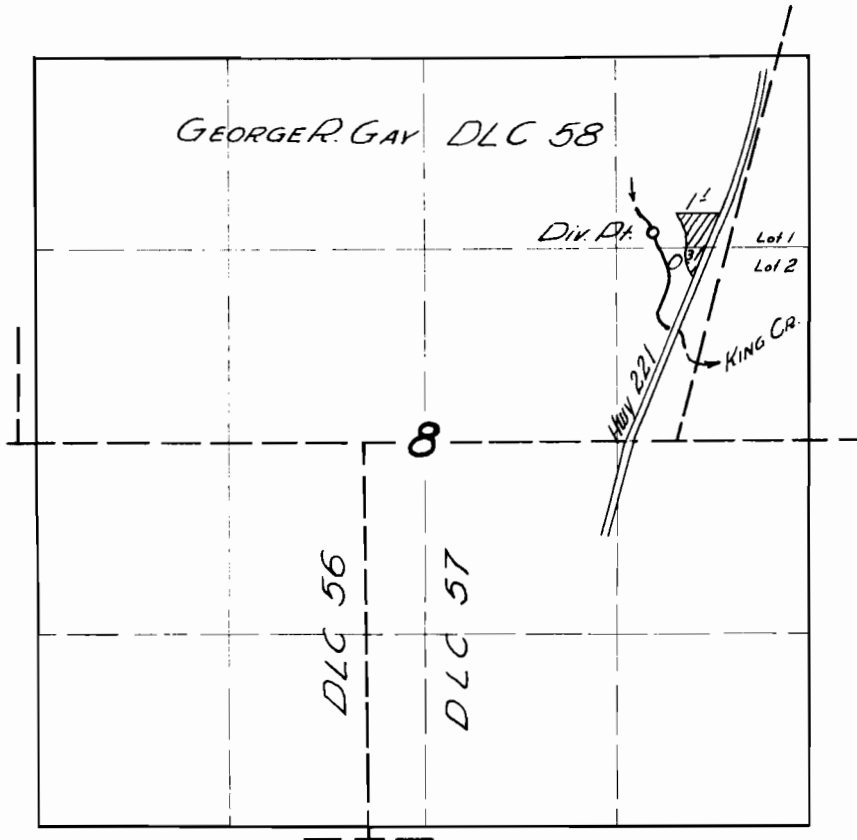

FINAL PROOF SURVEY
UNDER

Application No. 26137 ... Permit No. 20989
IN NAME OF

MARCUS & LEAH KAUFFMAN LIND

Surveyed 21 Mar. 1957, by [Signature]