


T. 15 S. R. 5 W. W.M.

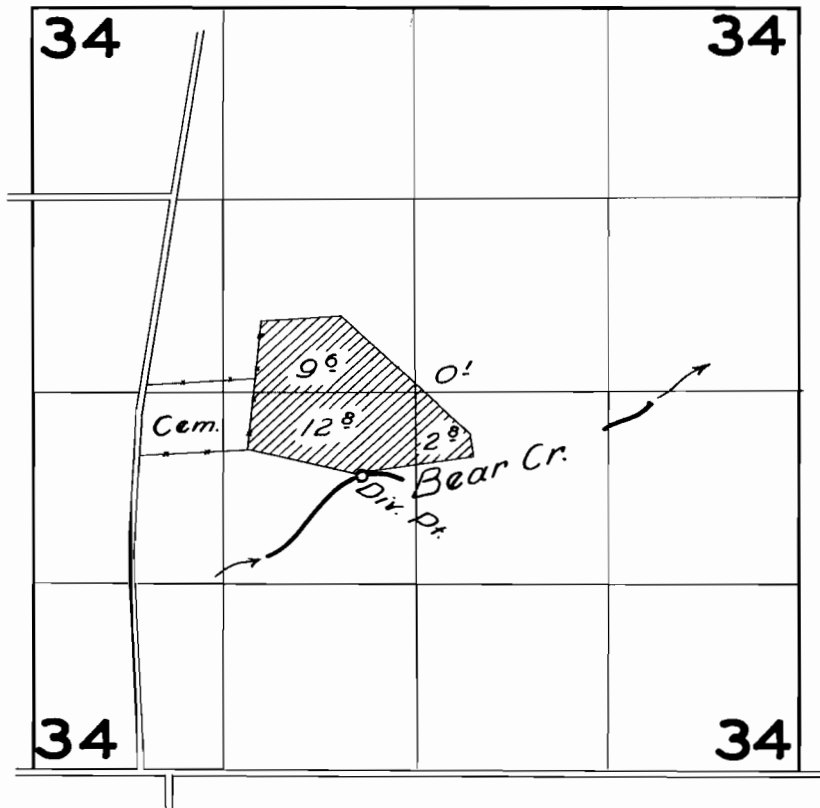

FINAL PROOF SURVEY
UNDER

Application No. 26943, Permit No. 21168
IN NAME OF

ROBERT P. DOERR

Surveyed 17 Apr. 1957, by *A. W. White*