


T. 2N. R. 10E. W. M.

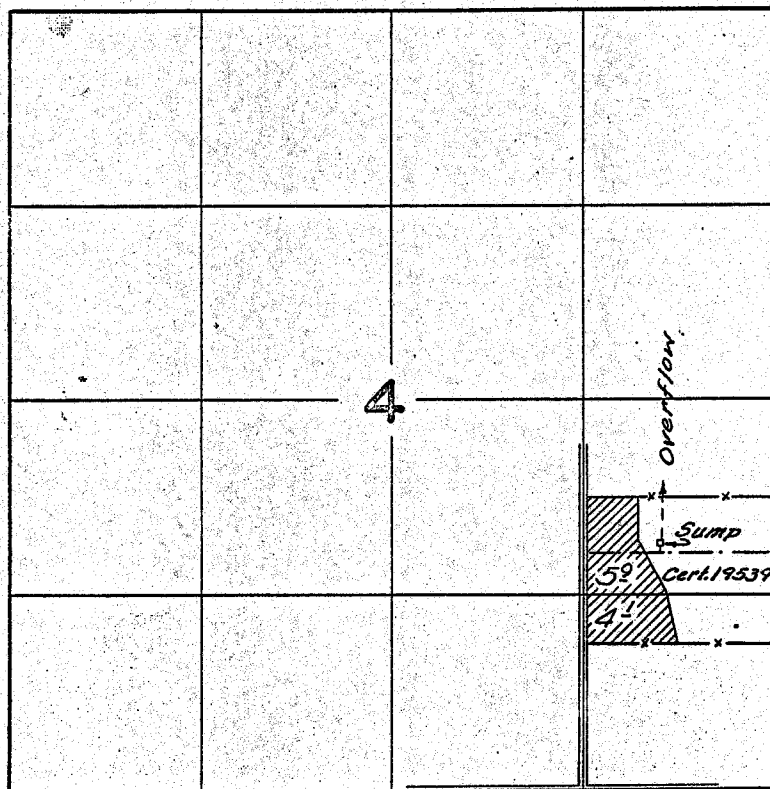

FINAL PROOF SURVEY UNDER

Application No. 27075. Permit No. 21303.
IN NAME OF

H.A. BENDLER

Surveyed *April 12, 1957*, by *C.O. Smith*