


T.16 S.R.4 E.W.M.

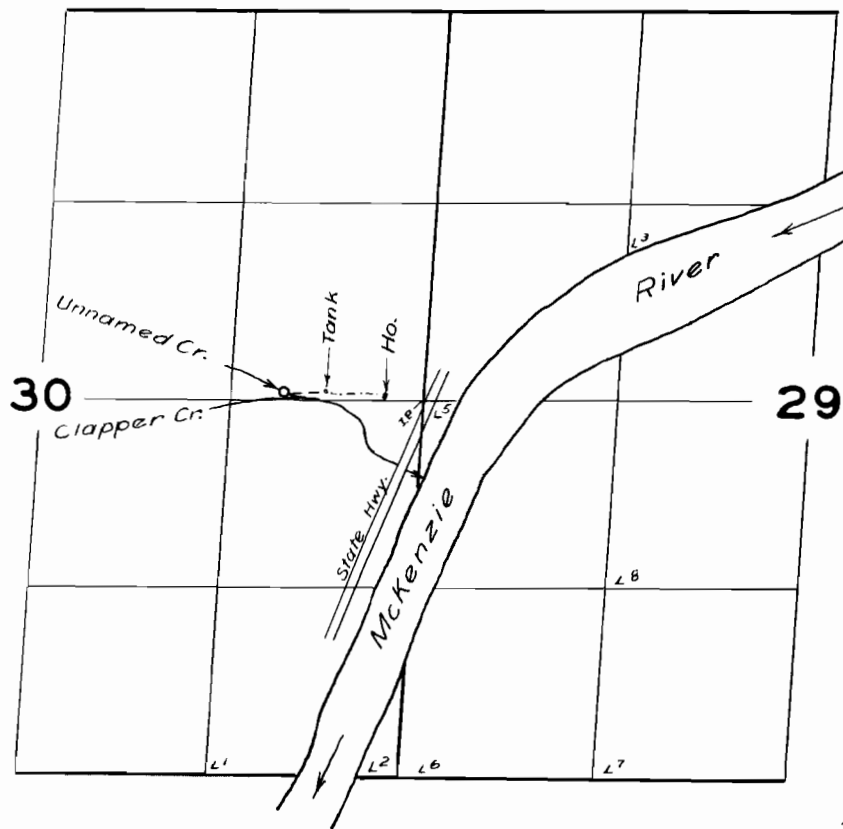

FINAL PROOF SURVEY

UNDER

Application No. 27109 Permit No. 21328

IN NAME OF

*Elmer Lanning or Amy Lanning*

Surveyed *June 28 1957*, by *M. Bish*