


T. 17S. R. 7W. W.M.

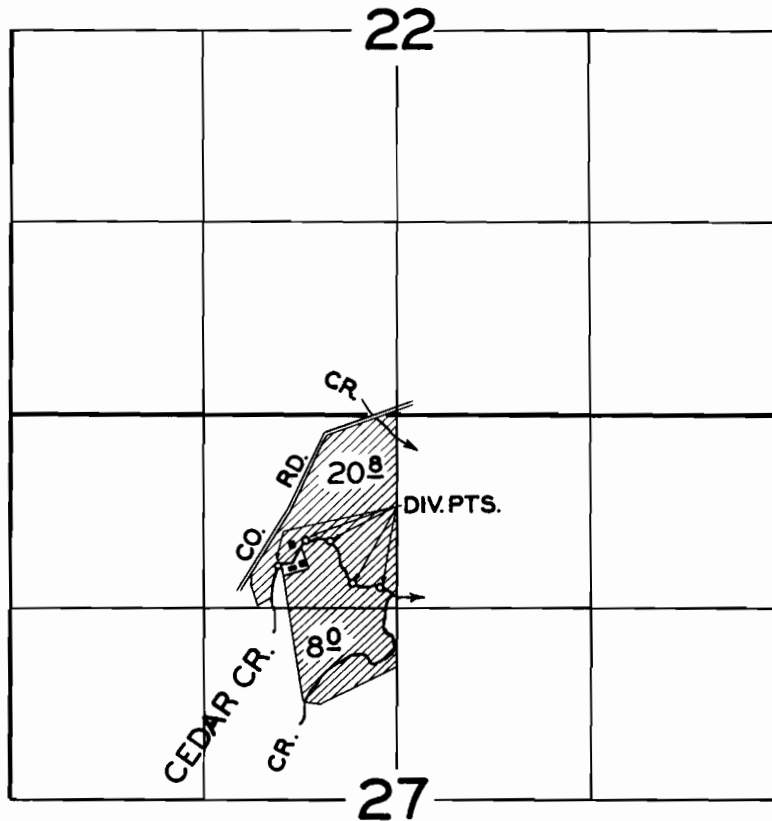

FINAL PROOF SURVEY
UNDER

Application No. 27330. Permit No. 21487.
IN NAME OF

MYRON O. BISHOP

Surveyed MAY 15, 1957, by *[Signature]*