


T. 17S. R. 9W. W.M.

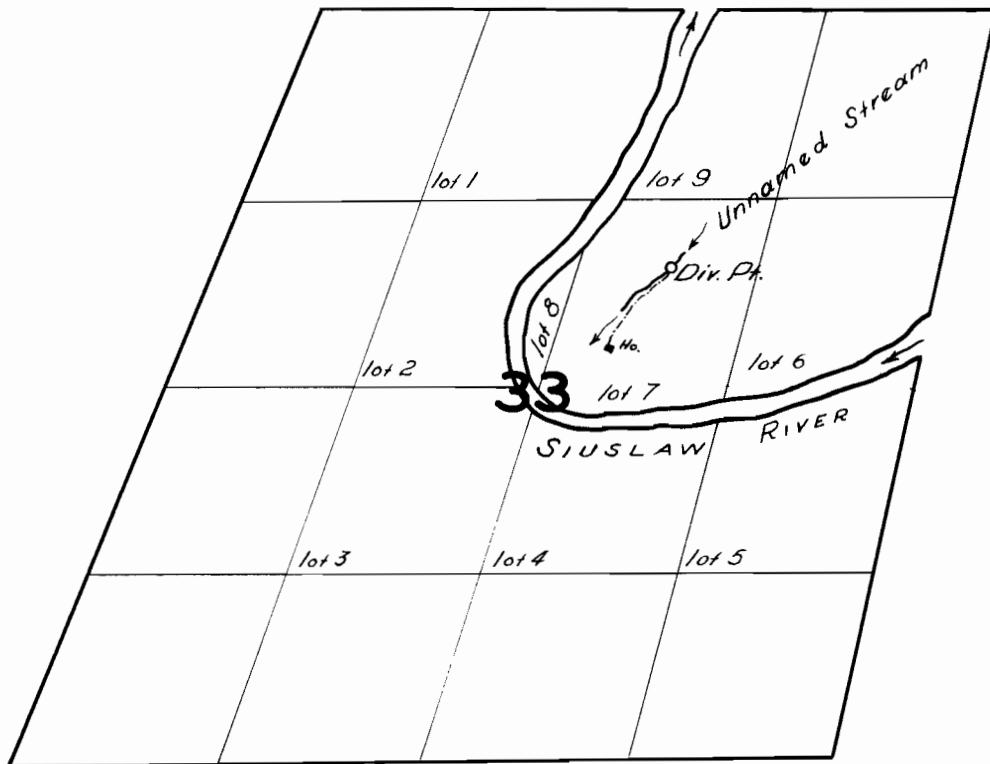

FINAL PROOF SURVEY
UNDER

Application No. 27263 Permit No. 21525
IN NAME OF

FRED M^cCORNACK

Surveyed 21 May 1957, by *Chas. Kilby*