


T. 36 S., R. 3 W., W.M.

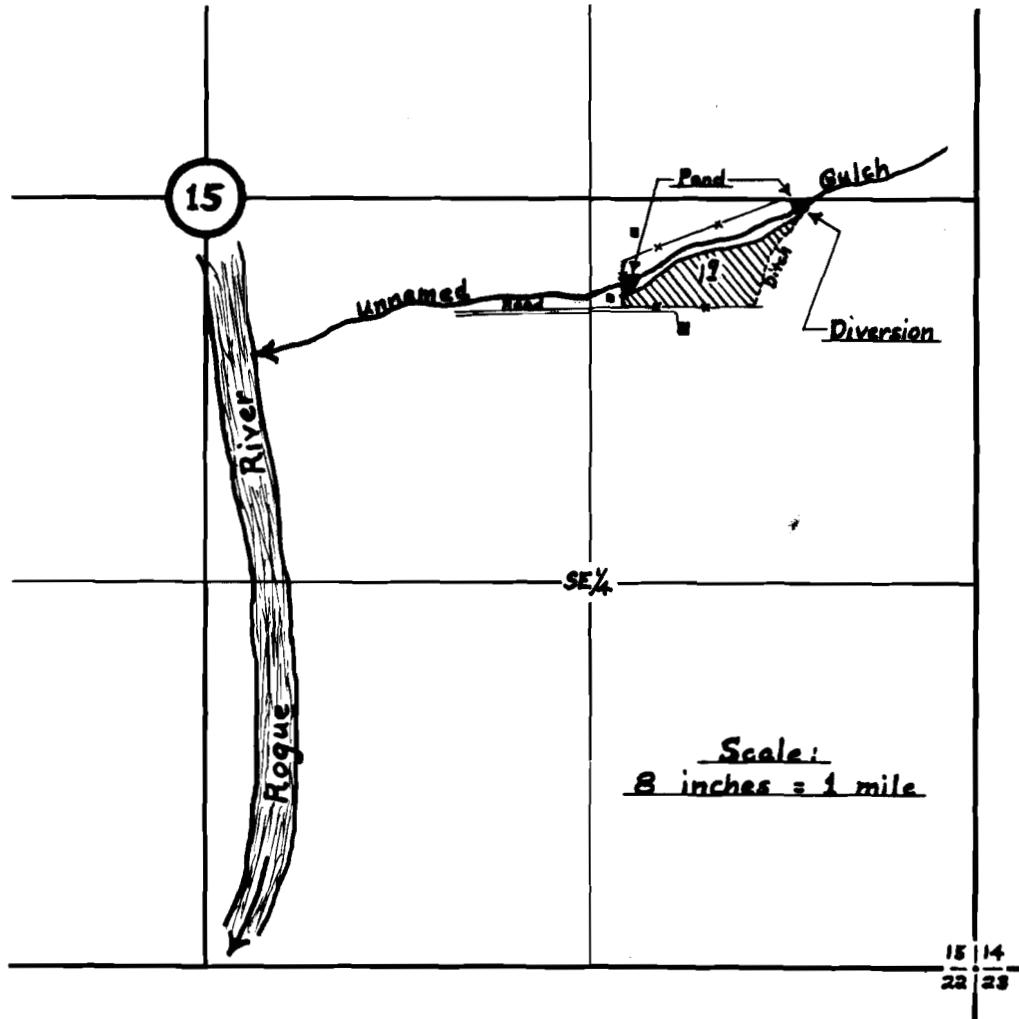

FINAL PROOF SURVEY

UNDER

Application No. ~~27345~~ Permit No. ~~21522~~

IN NAME OF

~~Edwin C. Vallmart~~

Surveyed March 28, 1958, by David C. Hendrix, W.M.