


T. 7 N. R. 2 W. W. M.

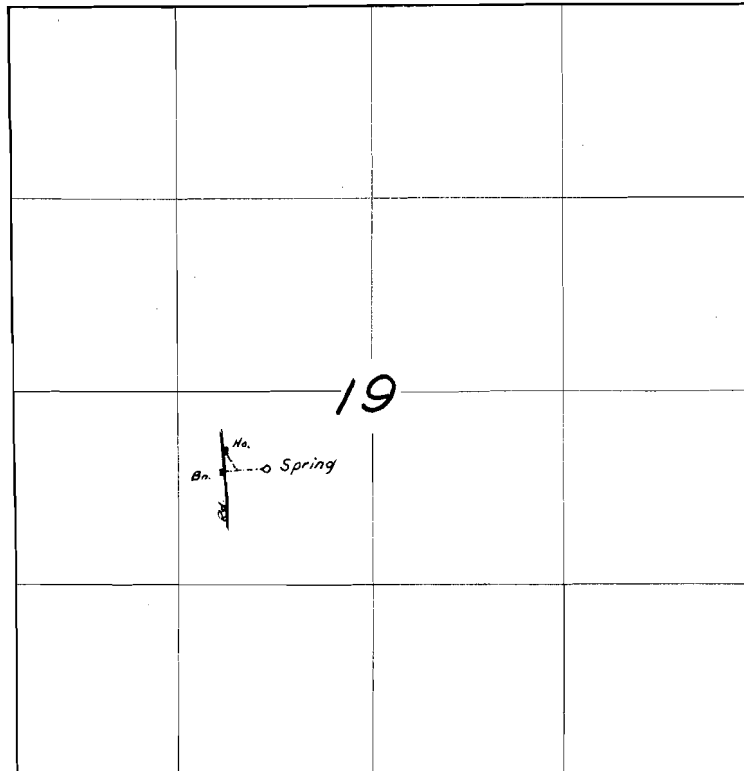

FINAL PROOF SURVEY
UNDER

Application No. 27731 Permit No. 21843
IN NAME OF

BURT CLOW

Surveyed 21 Aug. 19.50, by [Signature]