


T.13S.R.11&12W.W.M.

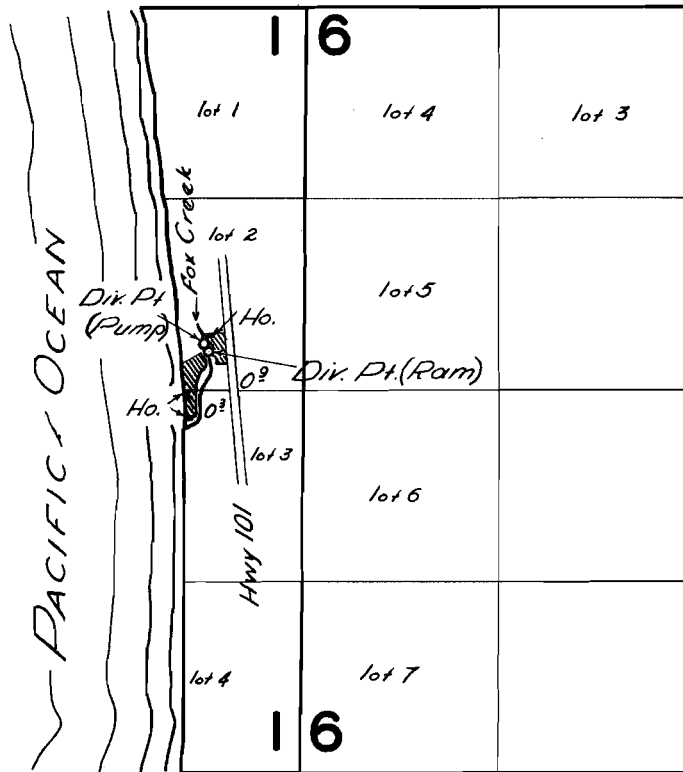

FINAL PROOF SURVEY
UNDER

Application No. 27829 Permit No. 21890

IN NAME OF

WEST COAST INVESTMENT CO.

Surveyed 16 June 1957, by C. H. Smith