


T.9 S.R.2 E.W.M.

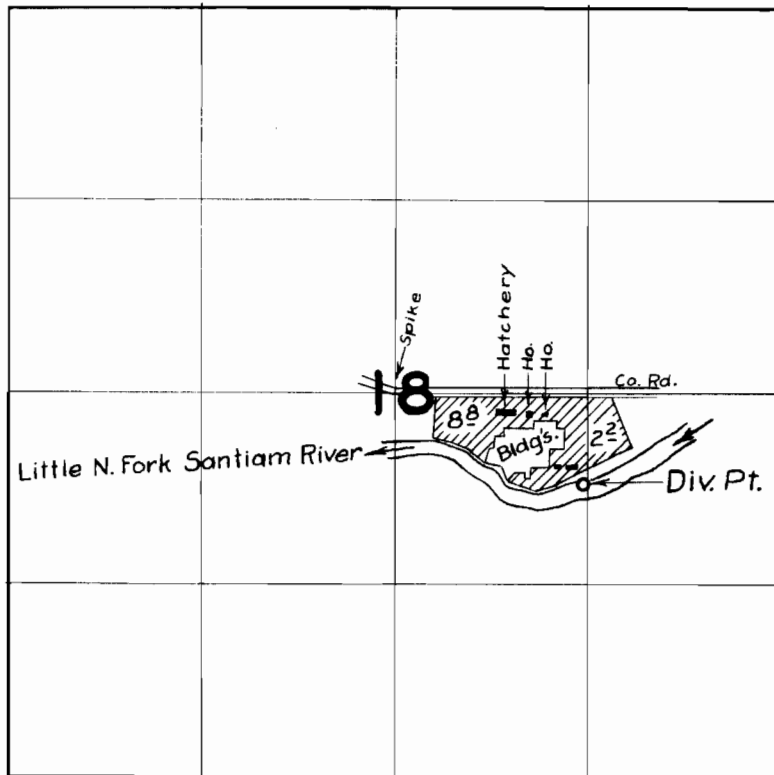

FINAL PROOF SURVEY UNDER

Application No. 27924 Permit No. 21994
IN NAME OF

Russell N. Wilson

Surveyed Aug. 30 1957, by M. Bish