


T.14S.R.5W.W.M.

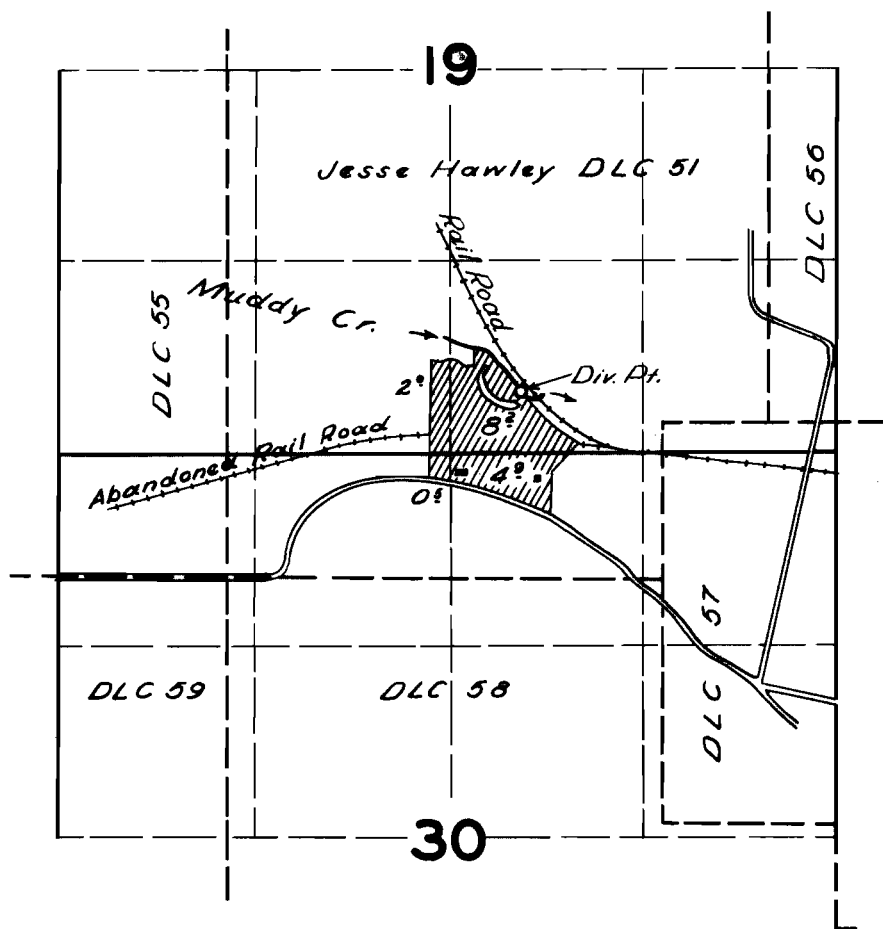

FINAL PROOF SURVEY

UNDER

Application No. 27954 Permit No. 22007

IN NAME OF

H. D. & CECILE WAGNER

Surveyed 26 Apr. 1957, by [Signature]