


T.I.S.R. 4W.W.M.

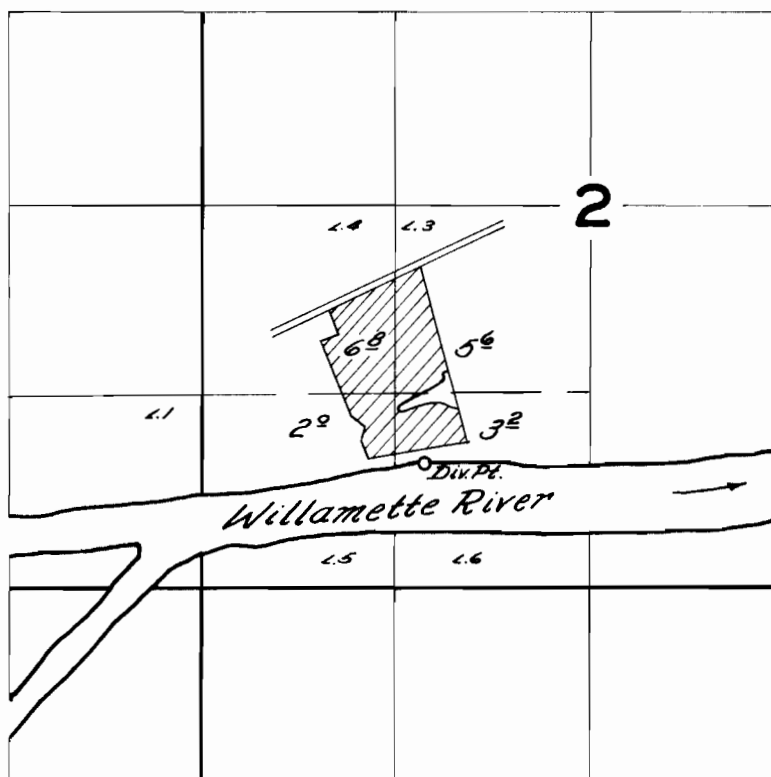

FINAL PROOF SURVEY UNDER

Application No. 27970 Permit No. 22014
IN NAME OF

John Goodhouse Jr.

Surveyed Aug. 15 1956, by C. Q. Bantle