


# T.8 & 9S.R.5W.W.M.

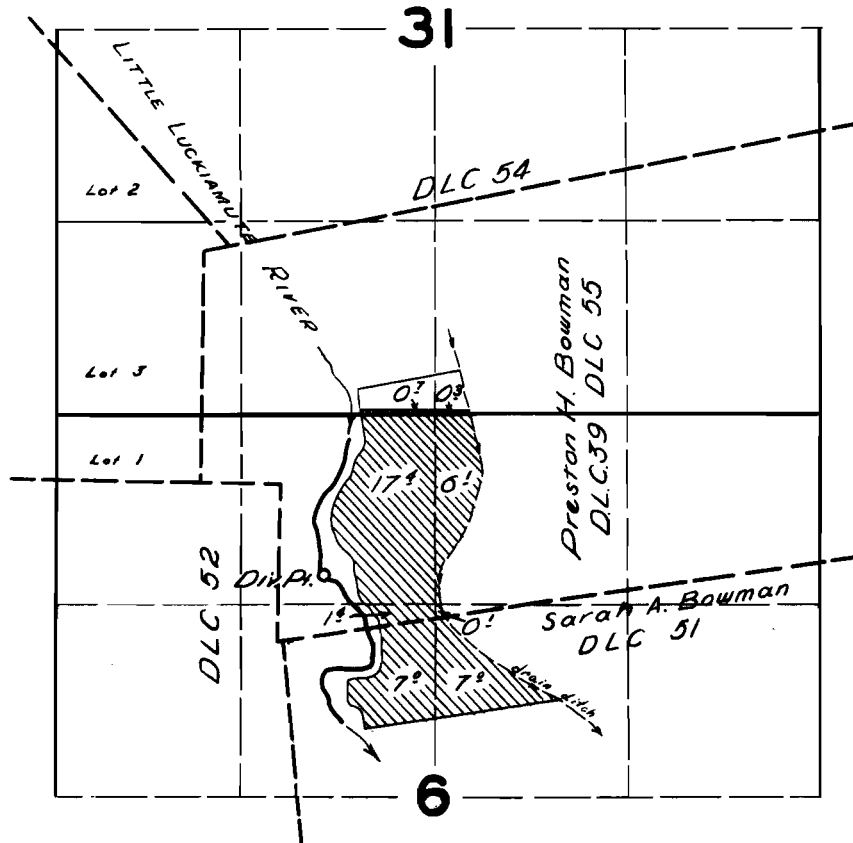

## FINAL PROOF SURVEY

UNDER

Application No. 26877 Permit No. 22090

IN NAME OF

CLINTON M. RUITER

Surveyed 1 April 1957, by [Signature]