


T.5S.R.7W.W.M.

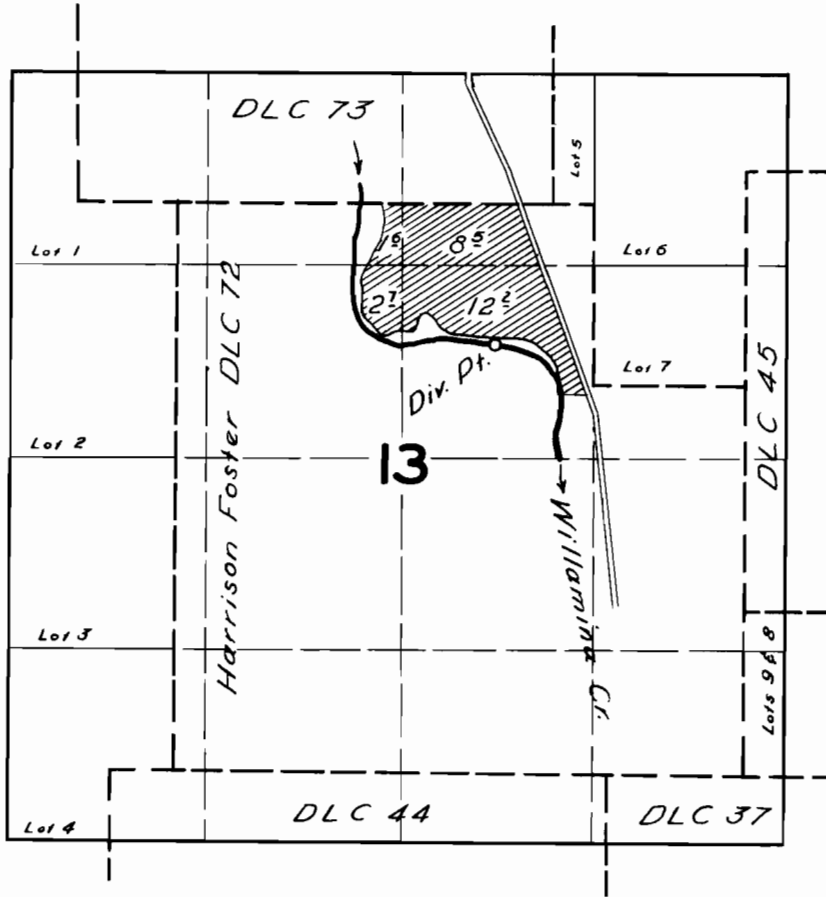

FINAL PROOF SURVEY
UNDER

Application No. 28101 Permit No. 22123
IN NAME OF

ROBERT H. WISE

Surveyed 7 June 1957, by [Signature]