


T. 10 S. R. 1 E. W. M.

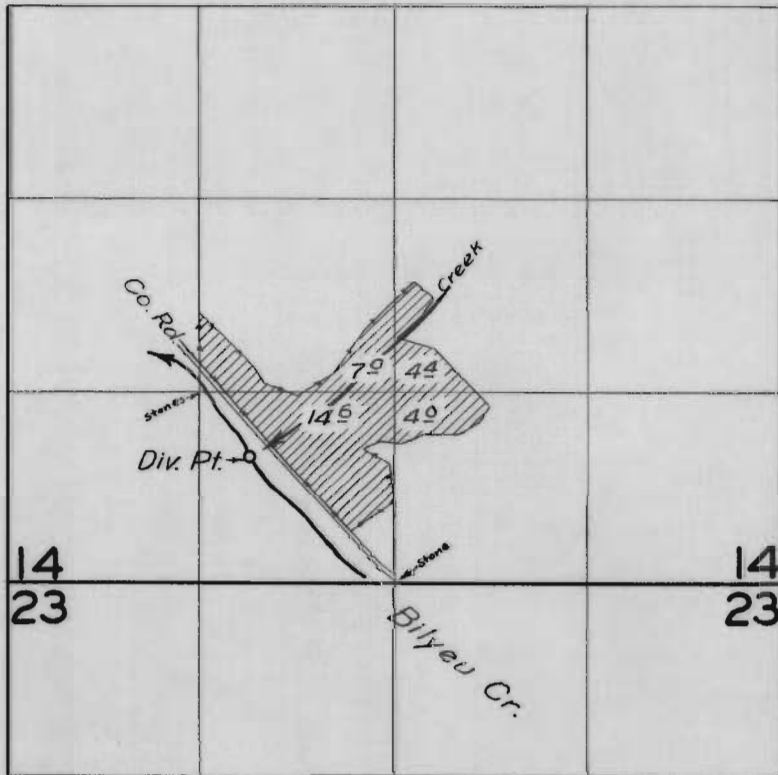

FINAL PROOF SURVEY UNDER

Application No. 28181 Permit No. 22176
IN NAME OF

Lawrence & Joan Silbernagel

Surveyed *May 31, 1957*, by *M. B. Bish*