


T. 7 S. R. 4 W. W.M.

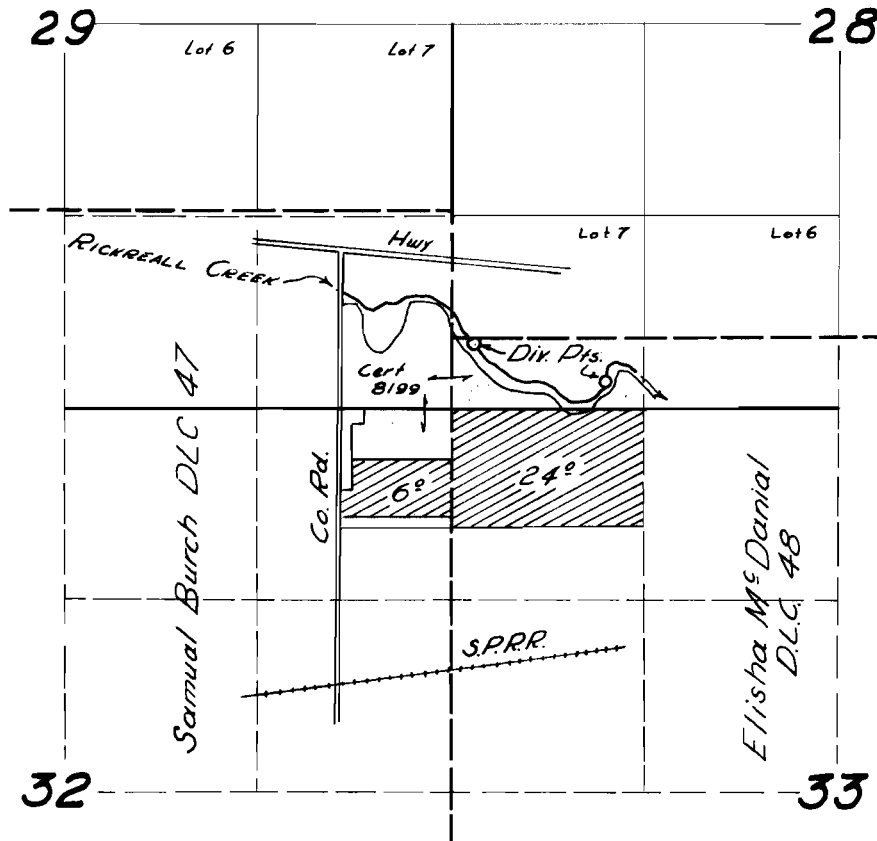

FINAL PROOF SURVEY

UNDER

Application No. 28197 Permit No. 22187

IN NAME OF

HENRY I. MORROW

Surveyed 19 Mar. 1957, by R. H. Heston