


T. 16S. R. 10W. W.M.

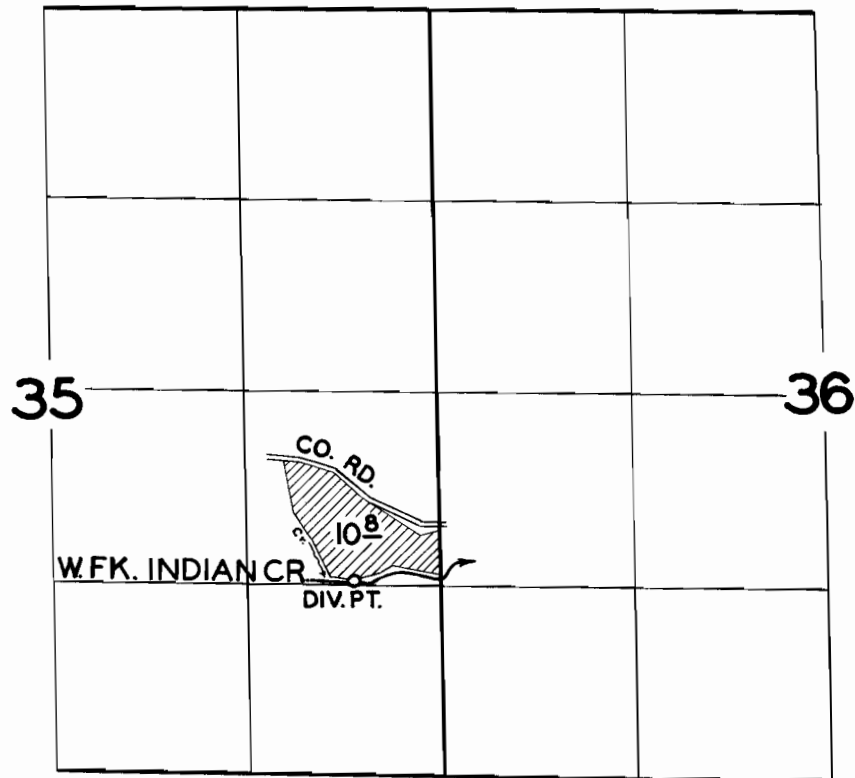

FINAL PROOF SURVEY
UNDER

Application No. 28246 Permit No. 22213
IN NAME OF

ARCHIE JEANS

Surveyed MAY 27 1957, by *Edwin H. Hays*