


T.18S.R.6W.W.M.

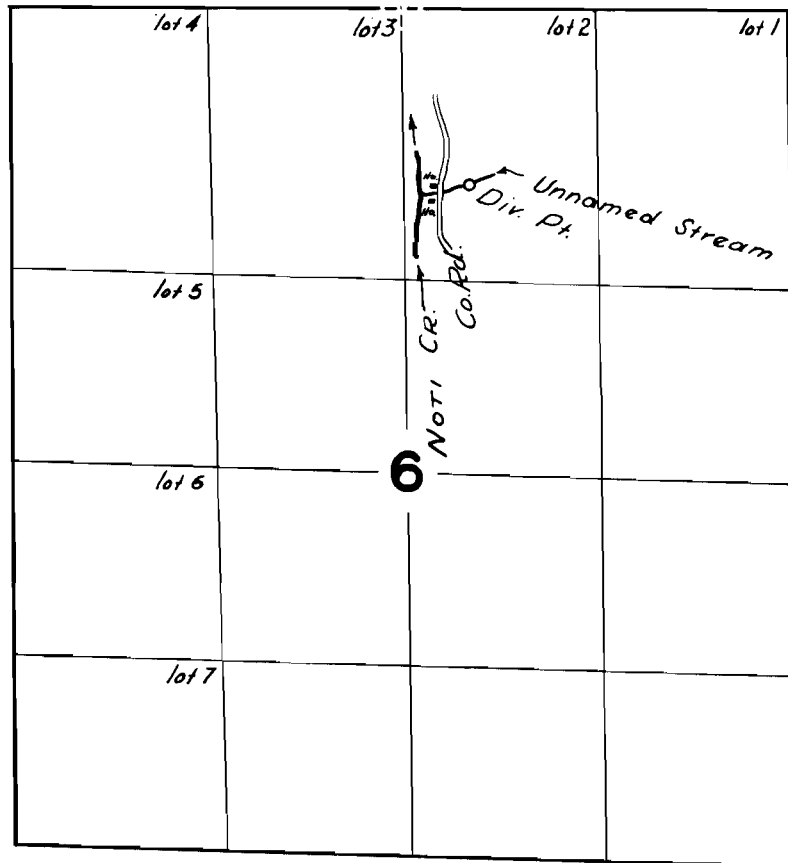

FINAL PROOF SURVEY
UNDER

Application No. 28463 Permit No. 22292
IN NAME OF

INEZ & EMERY GATES

Surveyed 5 May 1957, by [Signature]