


T.29S.R.6W.W.M.

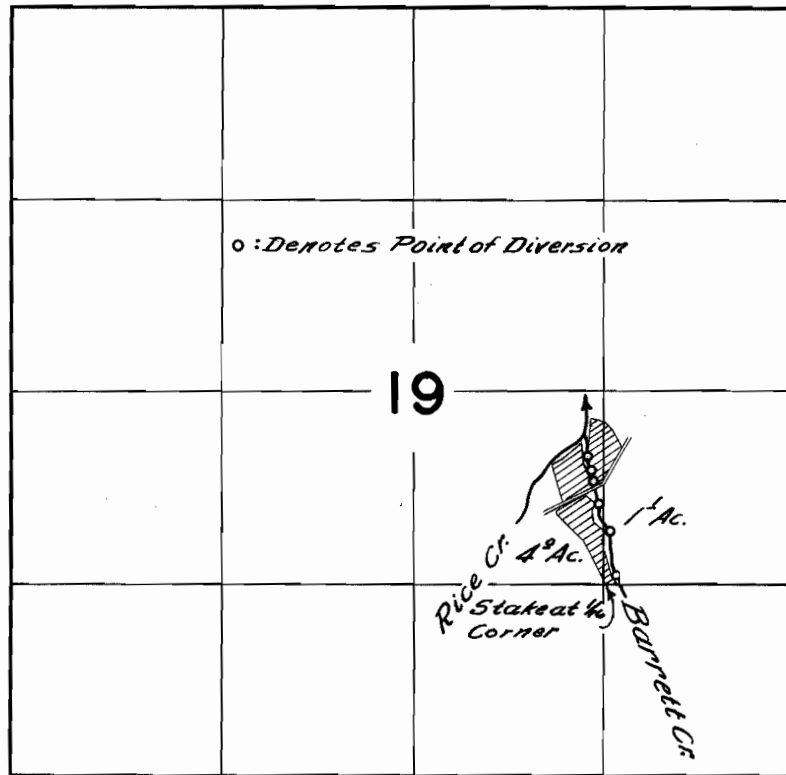

FINAL PROOF SURVEY UNDER

Application No. 28488 Permit No. 22309
IN NAME OF

GILBERT C. ROYER

Surveyed *April 9, 1957*, by *C.O. Burtch*