


T. 33 S. R. 6 W. W. M.

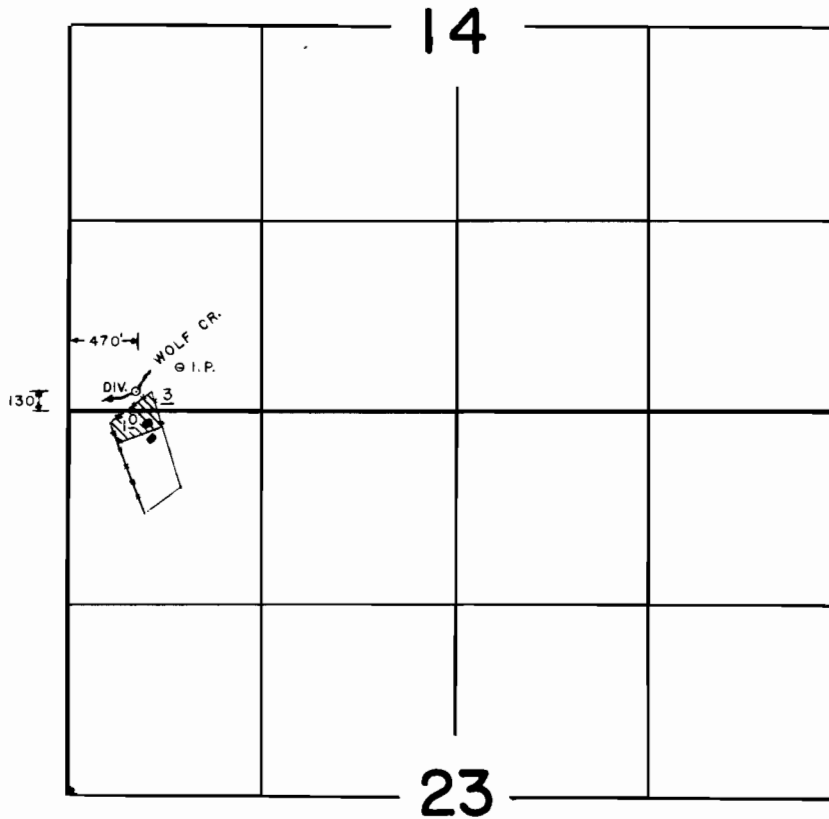

**FINAL PROOF SURVEY**  
UNDER

Application No. 5273 Permit No. 3184  
IN NAME OF

WILLIAM J. EASTON

Surveyed March 25 1966, by R.B. STEIMER