


T.6S.R.4W.W.M.

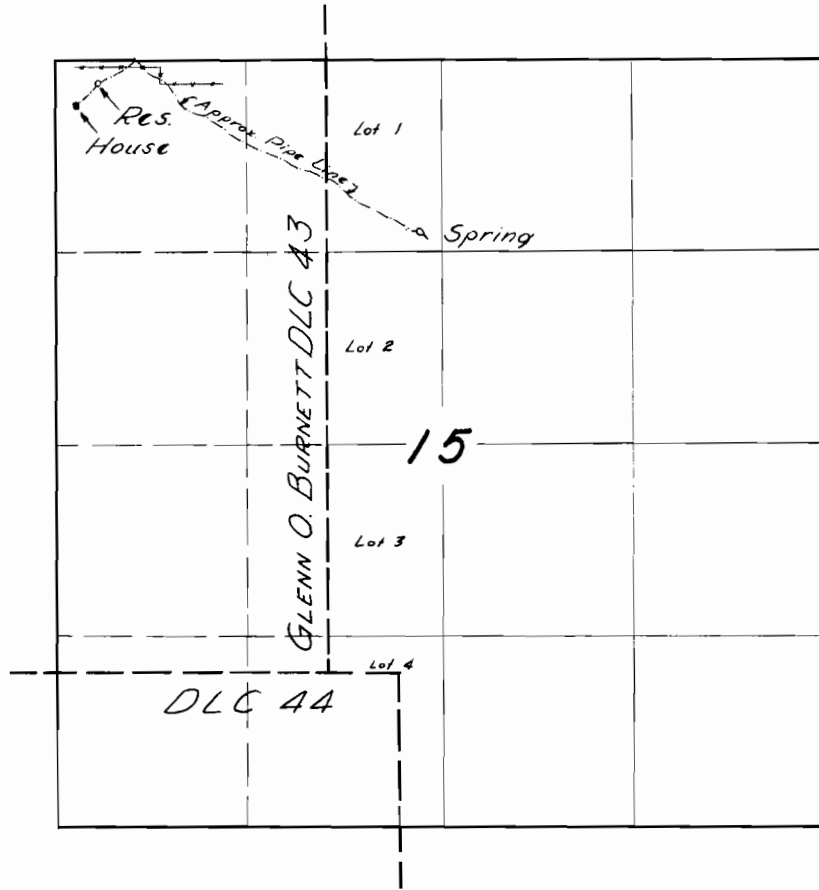

**FINAL PROOF SURVEY**  
UNDER

Application No. 28376 Permit No. 22388

IN NAME OF

EUGENE A. & ALBERTA S. HAHN

Surveyed 26 Mar. 1957, by [Signature]