


T.26S.R.6 W.W.M.

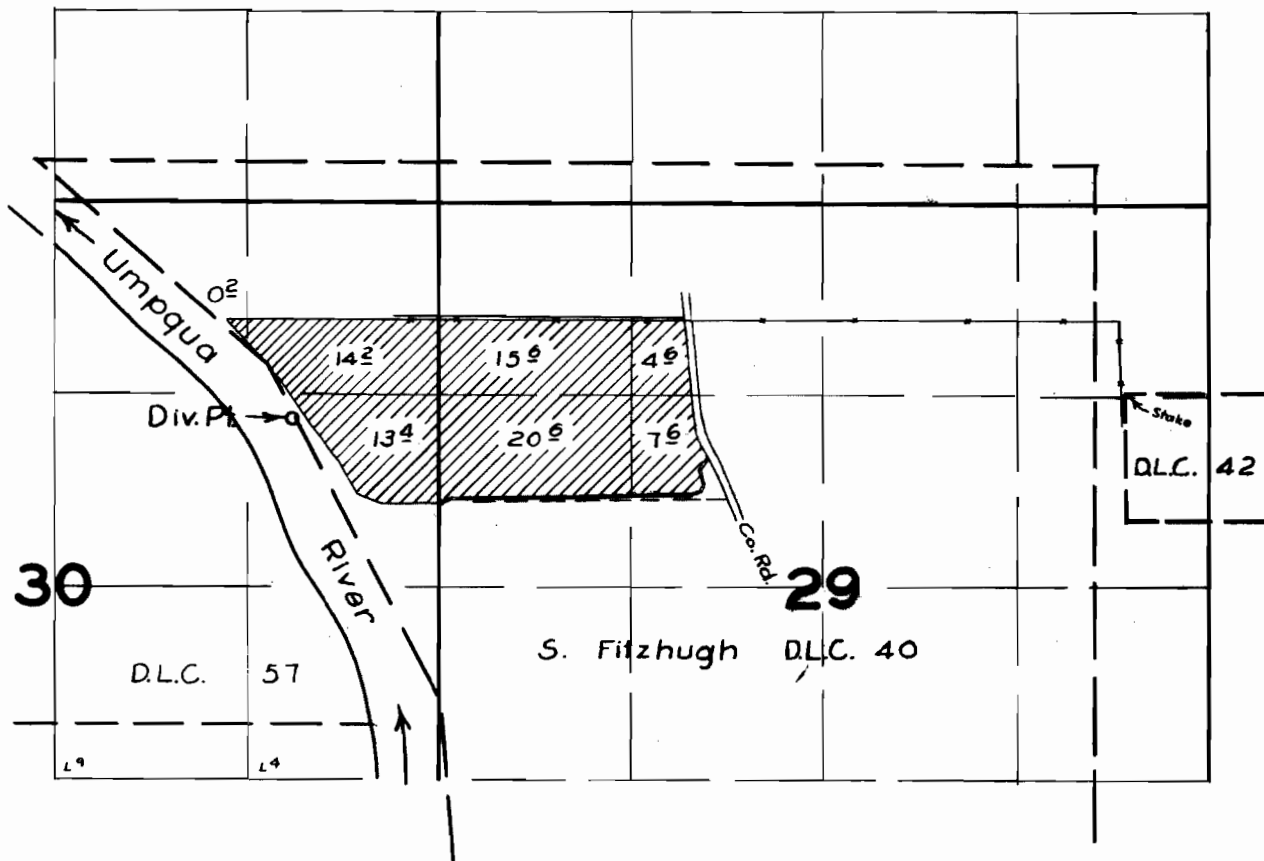

FINAL PROOF SURVEY
UNDER

Application No. 28142 Permit No. 22435
IN NAME OF

Hugh Ritchie

Surveyed Sept. 5, 1957, by M. B. Bick