


T.18S.R.1E.W.M.

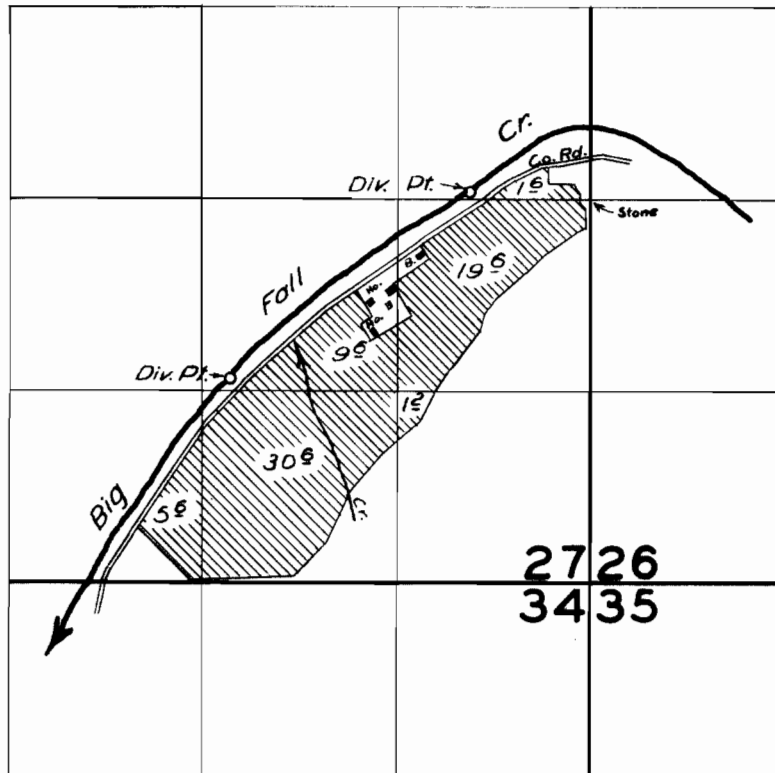

FINAL PROOF SURVEY

UNDER

Application No. 28701 Permit No. 22599

IN NAME OF

James W. & Margaret A. Waning

Surveyed June 19 1957, by m. Bish