


T.17 S.R.I E.W.M.

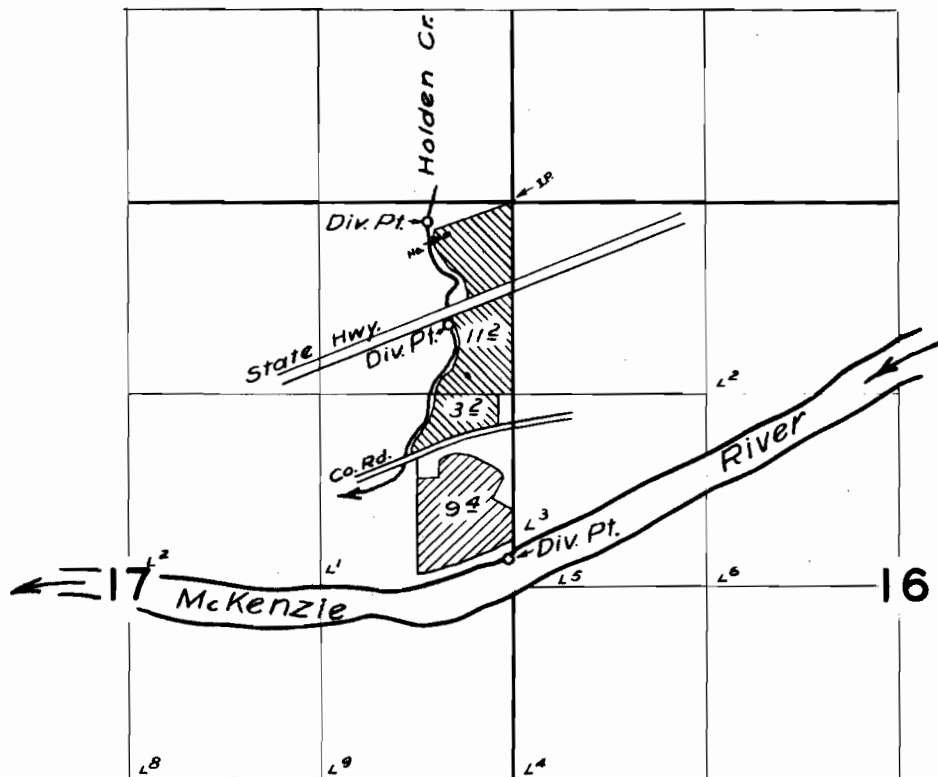

FINAL PROOF SURVEY UNDER

Application No. 28784 Permit No. 22658
IN NAME OF

Robert E. & Frieda M. Steele

Surveyed June 21/1957, by m. Bish