


T. 2N. R. 33E. W.M.

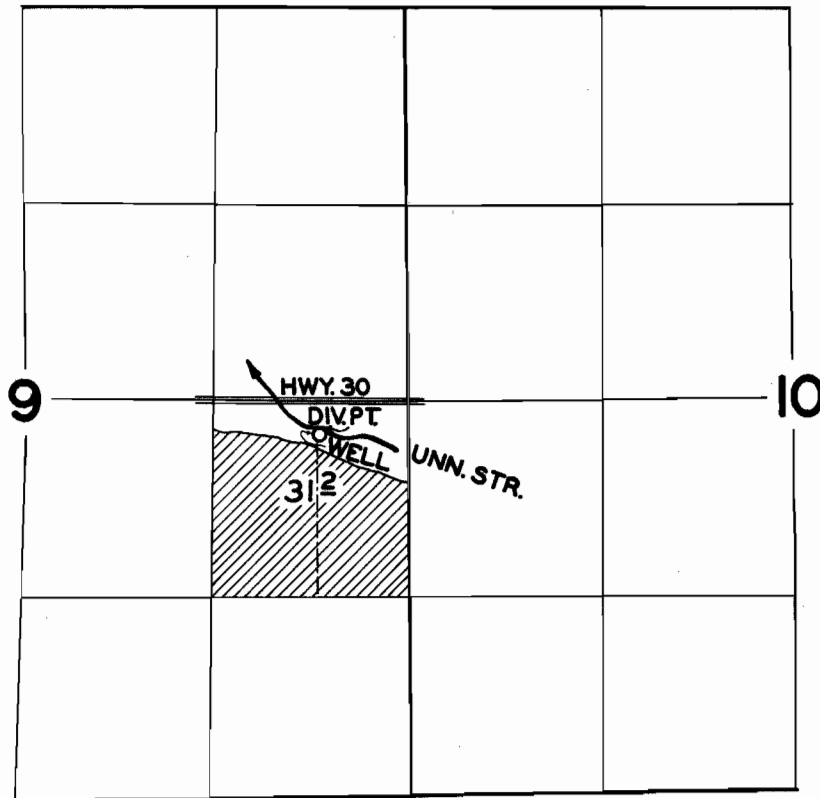

FINAL PROOF SURVEY

UNDER

Application No. 29052 U-749 Permit No. 22853 U-708

IN NAME OF

WILBUR L. & AGNES E. JONES

Surveyed MAY 29 1957, by C. O. Burtch