


T.16 S.R.2 E.W.M.

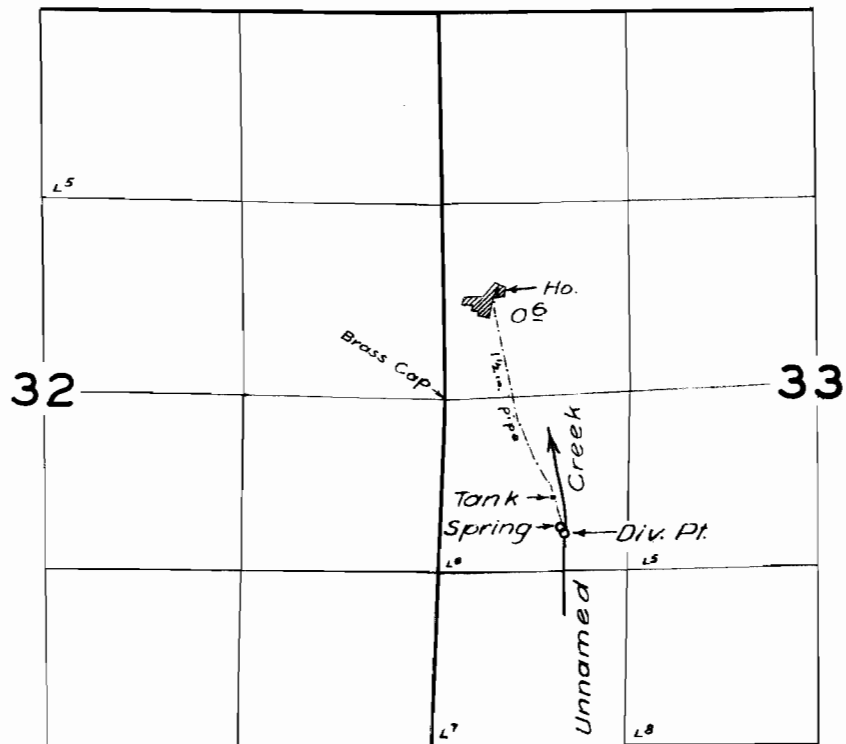

FINAL PROOF SURVEY
UNDER

Application No. 28208 Permit No. 22893.
IN NAME OF

Melvin Atterson

Surveyed June 27 1957, by M. Bish