


# T.30 S. R.5 W. W.M.

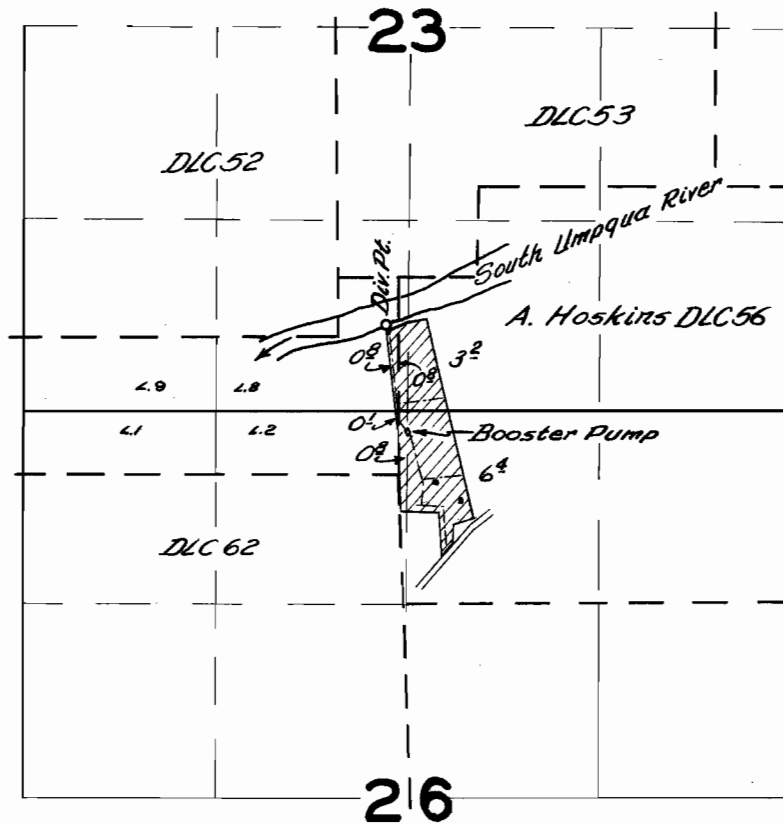

## FINAL PROOF SURVEY UNDER

Application No. 29228. Permit No. 23118  
IN NAME OF

*A. M. Cooper*

Surveyed April 15, 1957, by *C. O. Bartels*