


T.4S.R.12E.W.M.

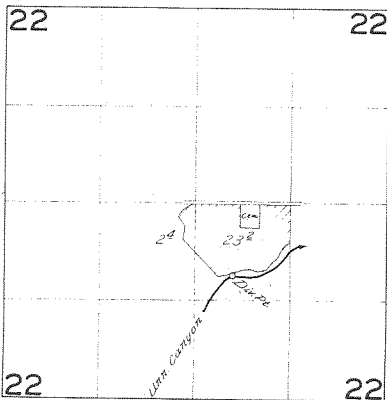

FINAL PROOF SURVEY  
UNDER

Application No. 27922 Permit No. 23225  
IN NAME OF

*George & Lucile Nelson*

Surveyed *Oct. 11 1957*, by *C.O. Bartlett*