


T7510
24261

T.14 S. R. 17 E. W.M.

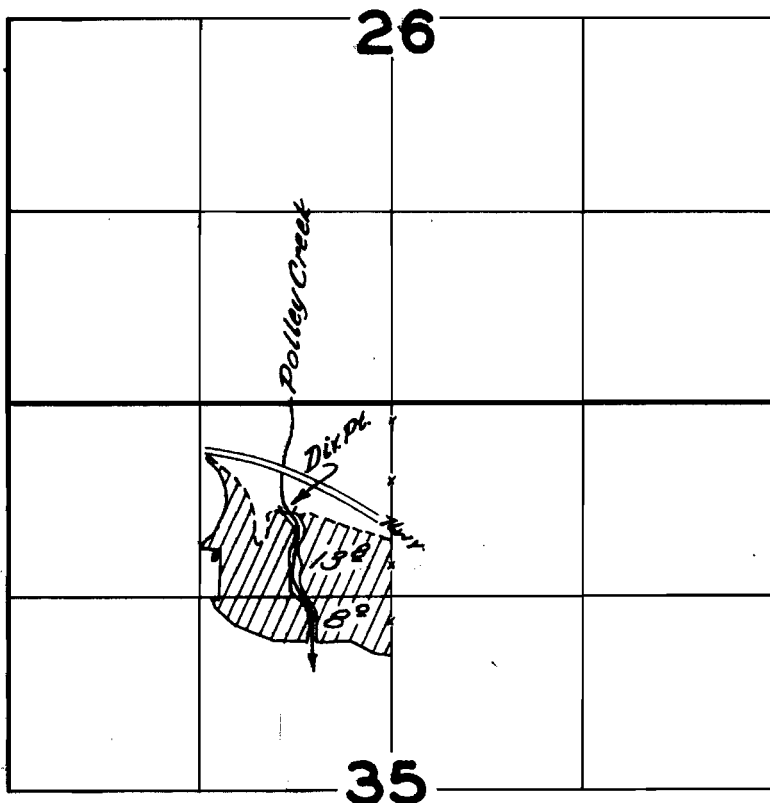

FINAL PROOF SURVEY UNDER

Application No. 29585. Permit No. 23299.
IN NAME OF

.....*Gilbert Lawson*.....

Surveyed *Aug. 2* 1957, by *OO Smith*

23299