


T. 12 S. R. 7 W. WM

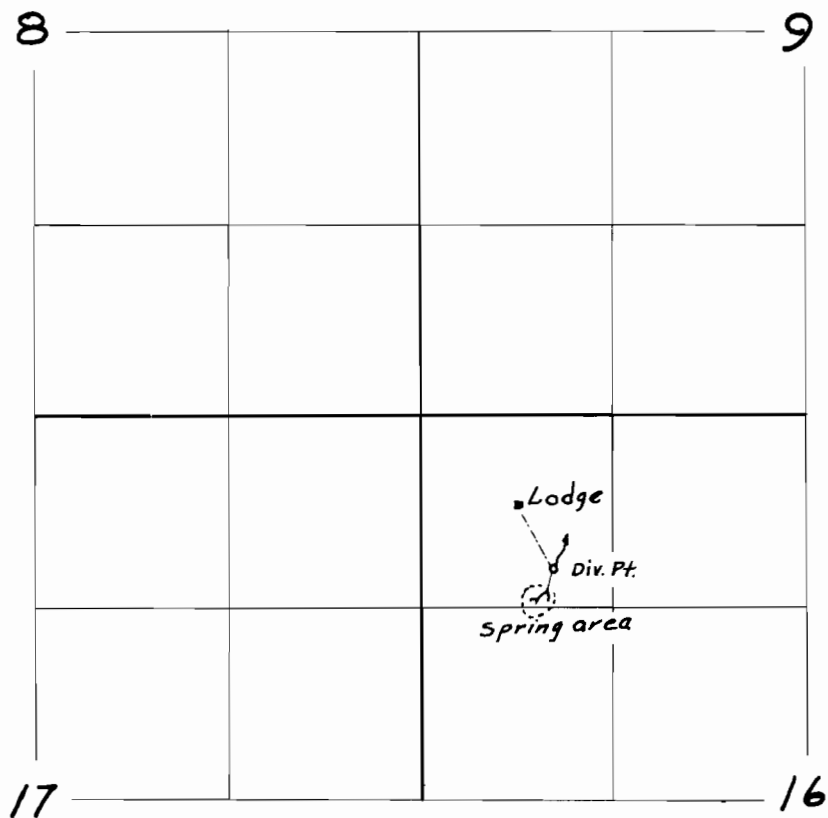

FINAL PROOF SURVEY
UNDER

Application No. 17684 Permit No. 13374
IN NAME OF

Knights of Pythias, Valley Lodge No 11

Surveyed May 12 1958, by R.H. Whitby