


T. 4N. R. 28E.W.M.

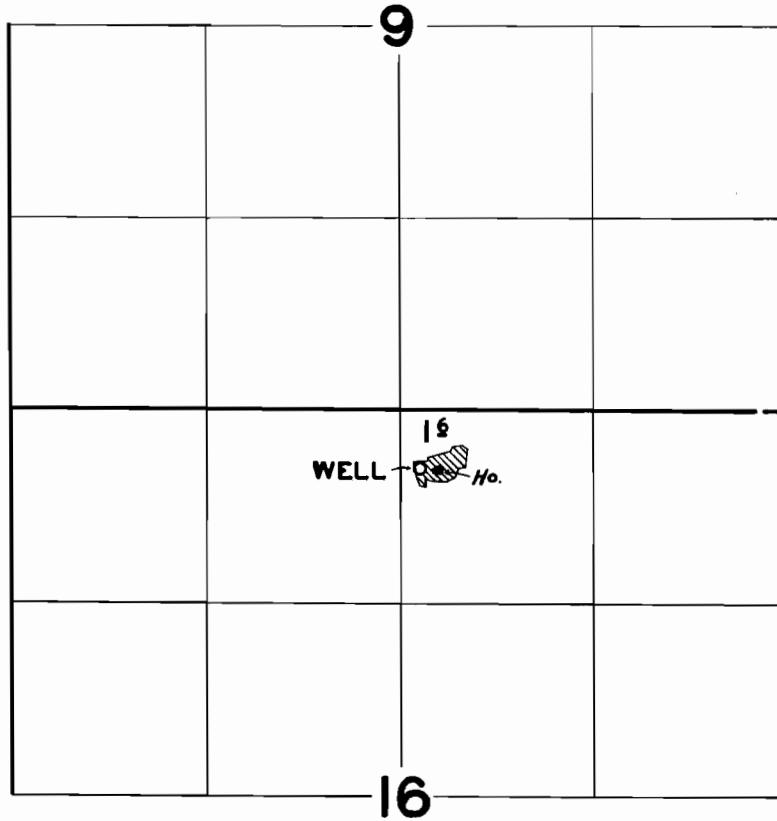

FINAL PROOF SURVEY

UNDER

Application No. U-357 Permit No. U-331

IN NAME OF

ALLAN C. & FLORINE R. LANGENWALTER

Surveyed MAY 15 1957, by *C.O. Bartels*