


T.7S. R.17E. WM

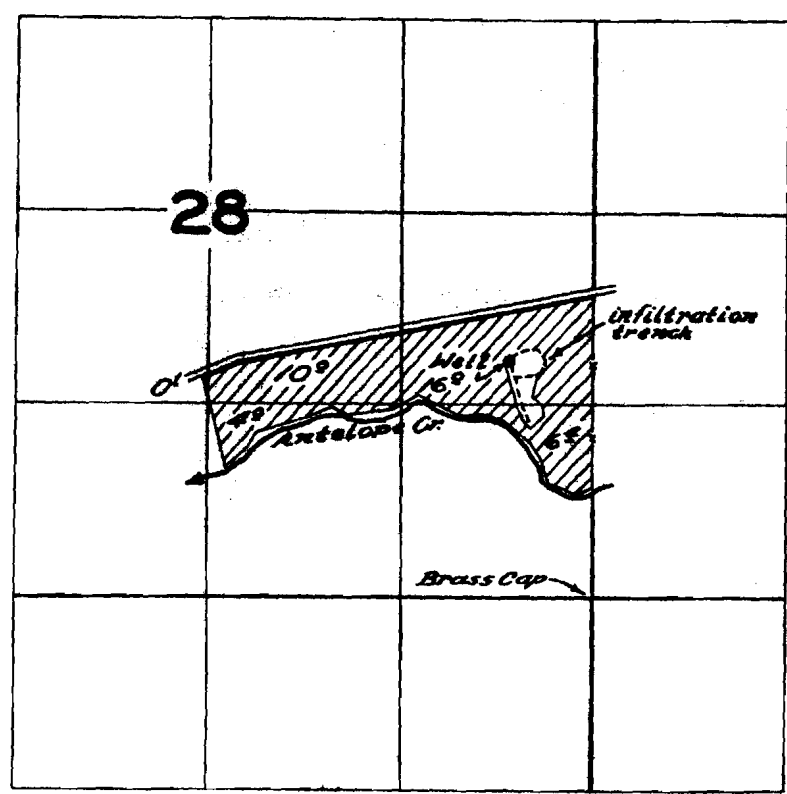

FINAL PROOF SURVEY UNDER

Application No. 44-613 Permit No. 44-560
IN NAME OF cert-24266

Frank T. & Edna June Thomas

Surveyed Oct. 13, 1957, by C.O. Carls