


T. 15. R. 32E. WM.

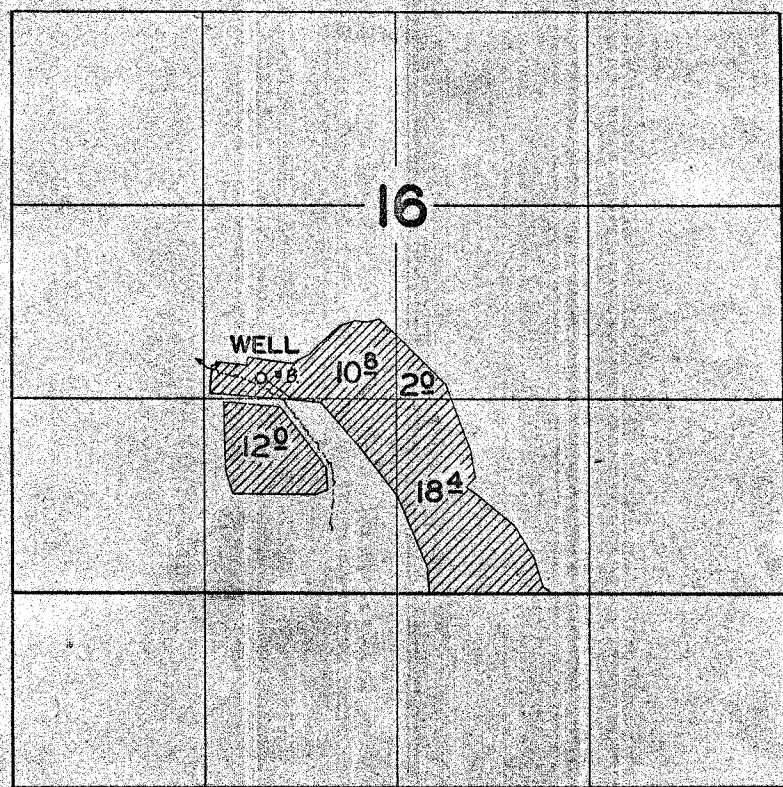

FINAL PROOF SURVEY UNDER

Application No. U-732 Permit No. U-646
 IN NAME OF
BILL ETTER

Surveyed MAY 9 1957, by C. O. Bartlett