


T.10 S. R.1 W. W.M.

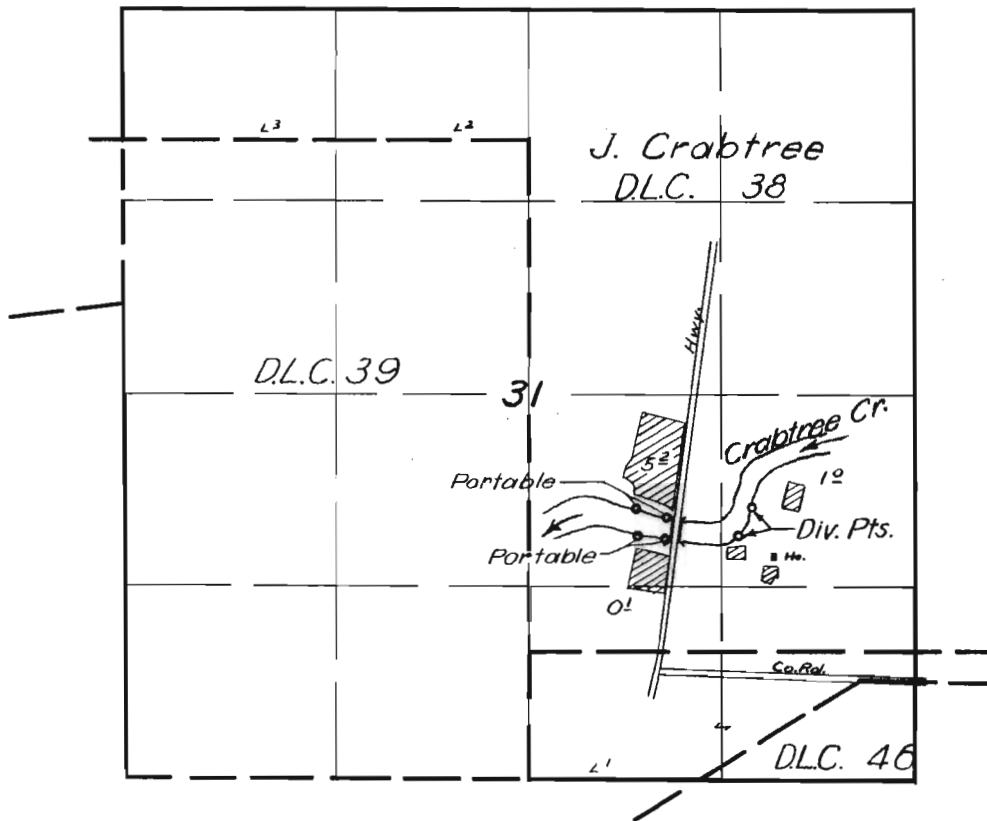

**FINAL PROOF SURVEY**  
UNDER

Application No. 16098 Permit No. 11917  
IN NAME OF

*Clara Horsburgh*

Surveyed *Mar 19 1957*, by *M. Bish*