


T. 6 N., R. 35 E., W. M.

Washington

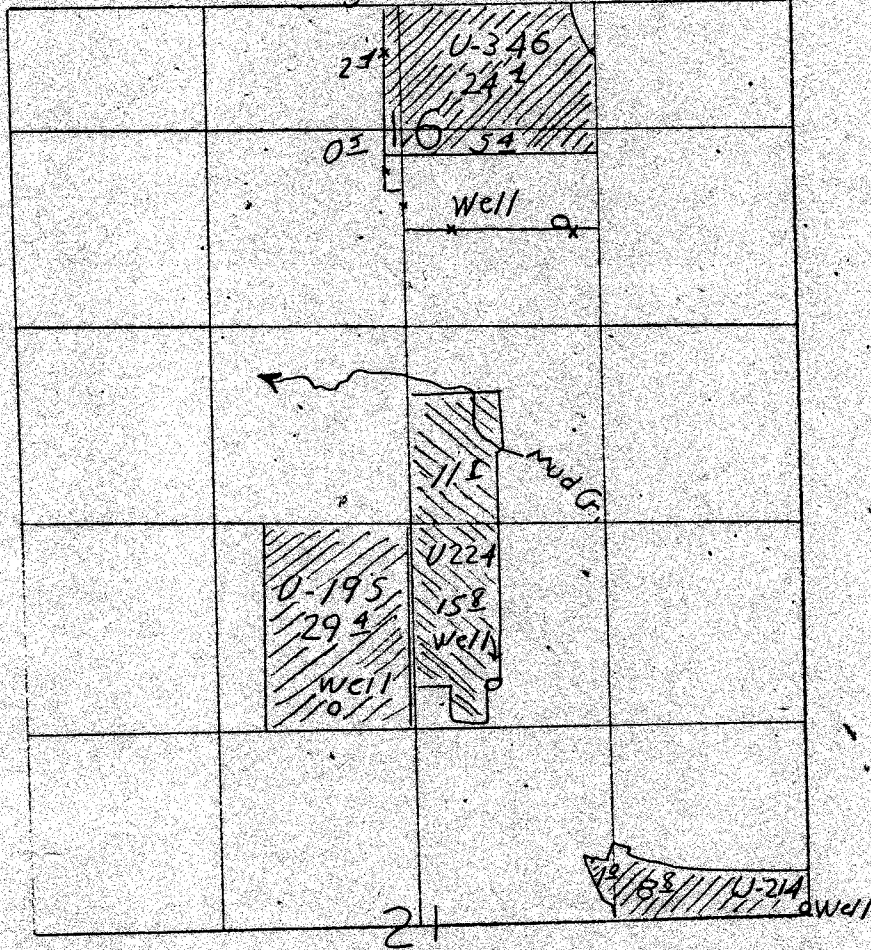

FINAL PROOF SURVEY

	Appl. No.	Permit No.
Mrs. Matilda Johnson	U-214	U-199
George E. Hodgen	U-195	U-177
Walker C. & Bertha P. Ellis	U-224	U-207
Lawrence & Maxine McBride	U-346	U-318

Traced in State Engineers Office