


# T. 2N. R. 27E. W.M.

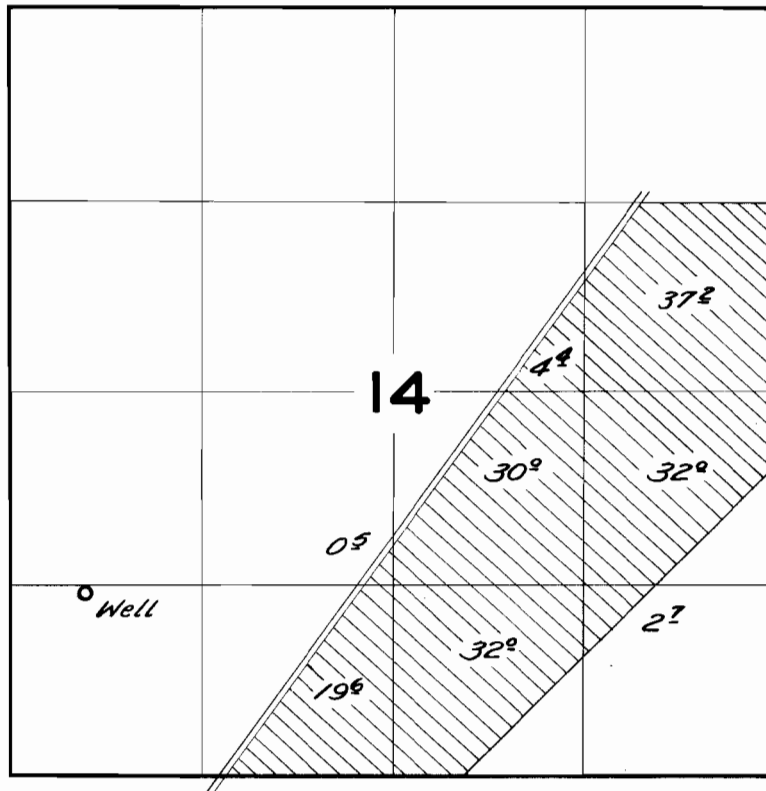

## FINAL PROOF SURVEY UNDER

Application No. *LL-587* Permit No. *LL-536*  
IN NAME OF

*Oscar D. McCarty*

Surveyed *May 28* 1957 by *C.O. Curtis*