


T. 2S, R. 3W, W.M.

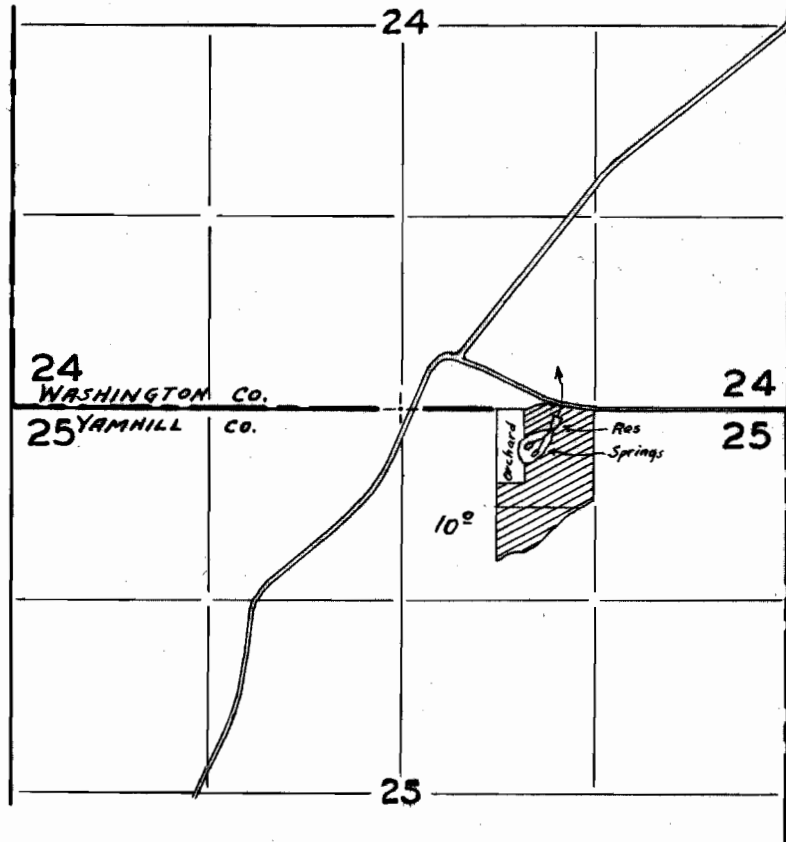

FINAL PROOF SURVEY

UNDER

R-25053

R-1191

Application No. 25054 Permit No. 20493

IN NAME OF

FRANKLIN J. & IRENE H. SHINE

Surveyed 5-2 1956, by R.H. WHITBY