


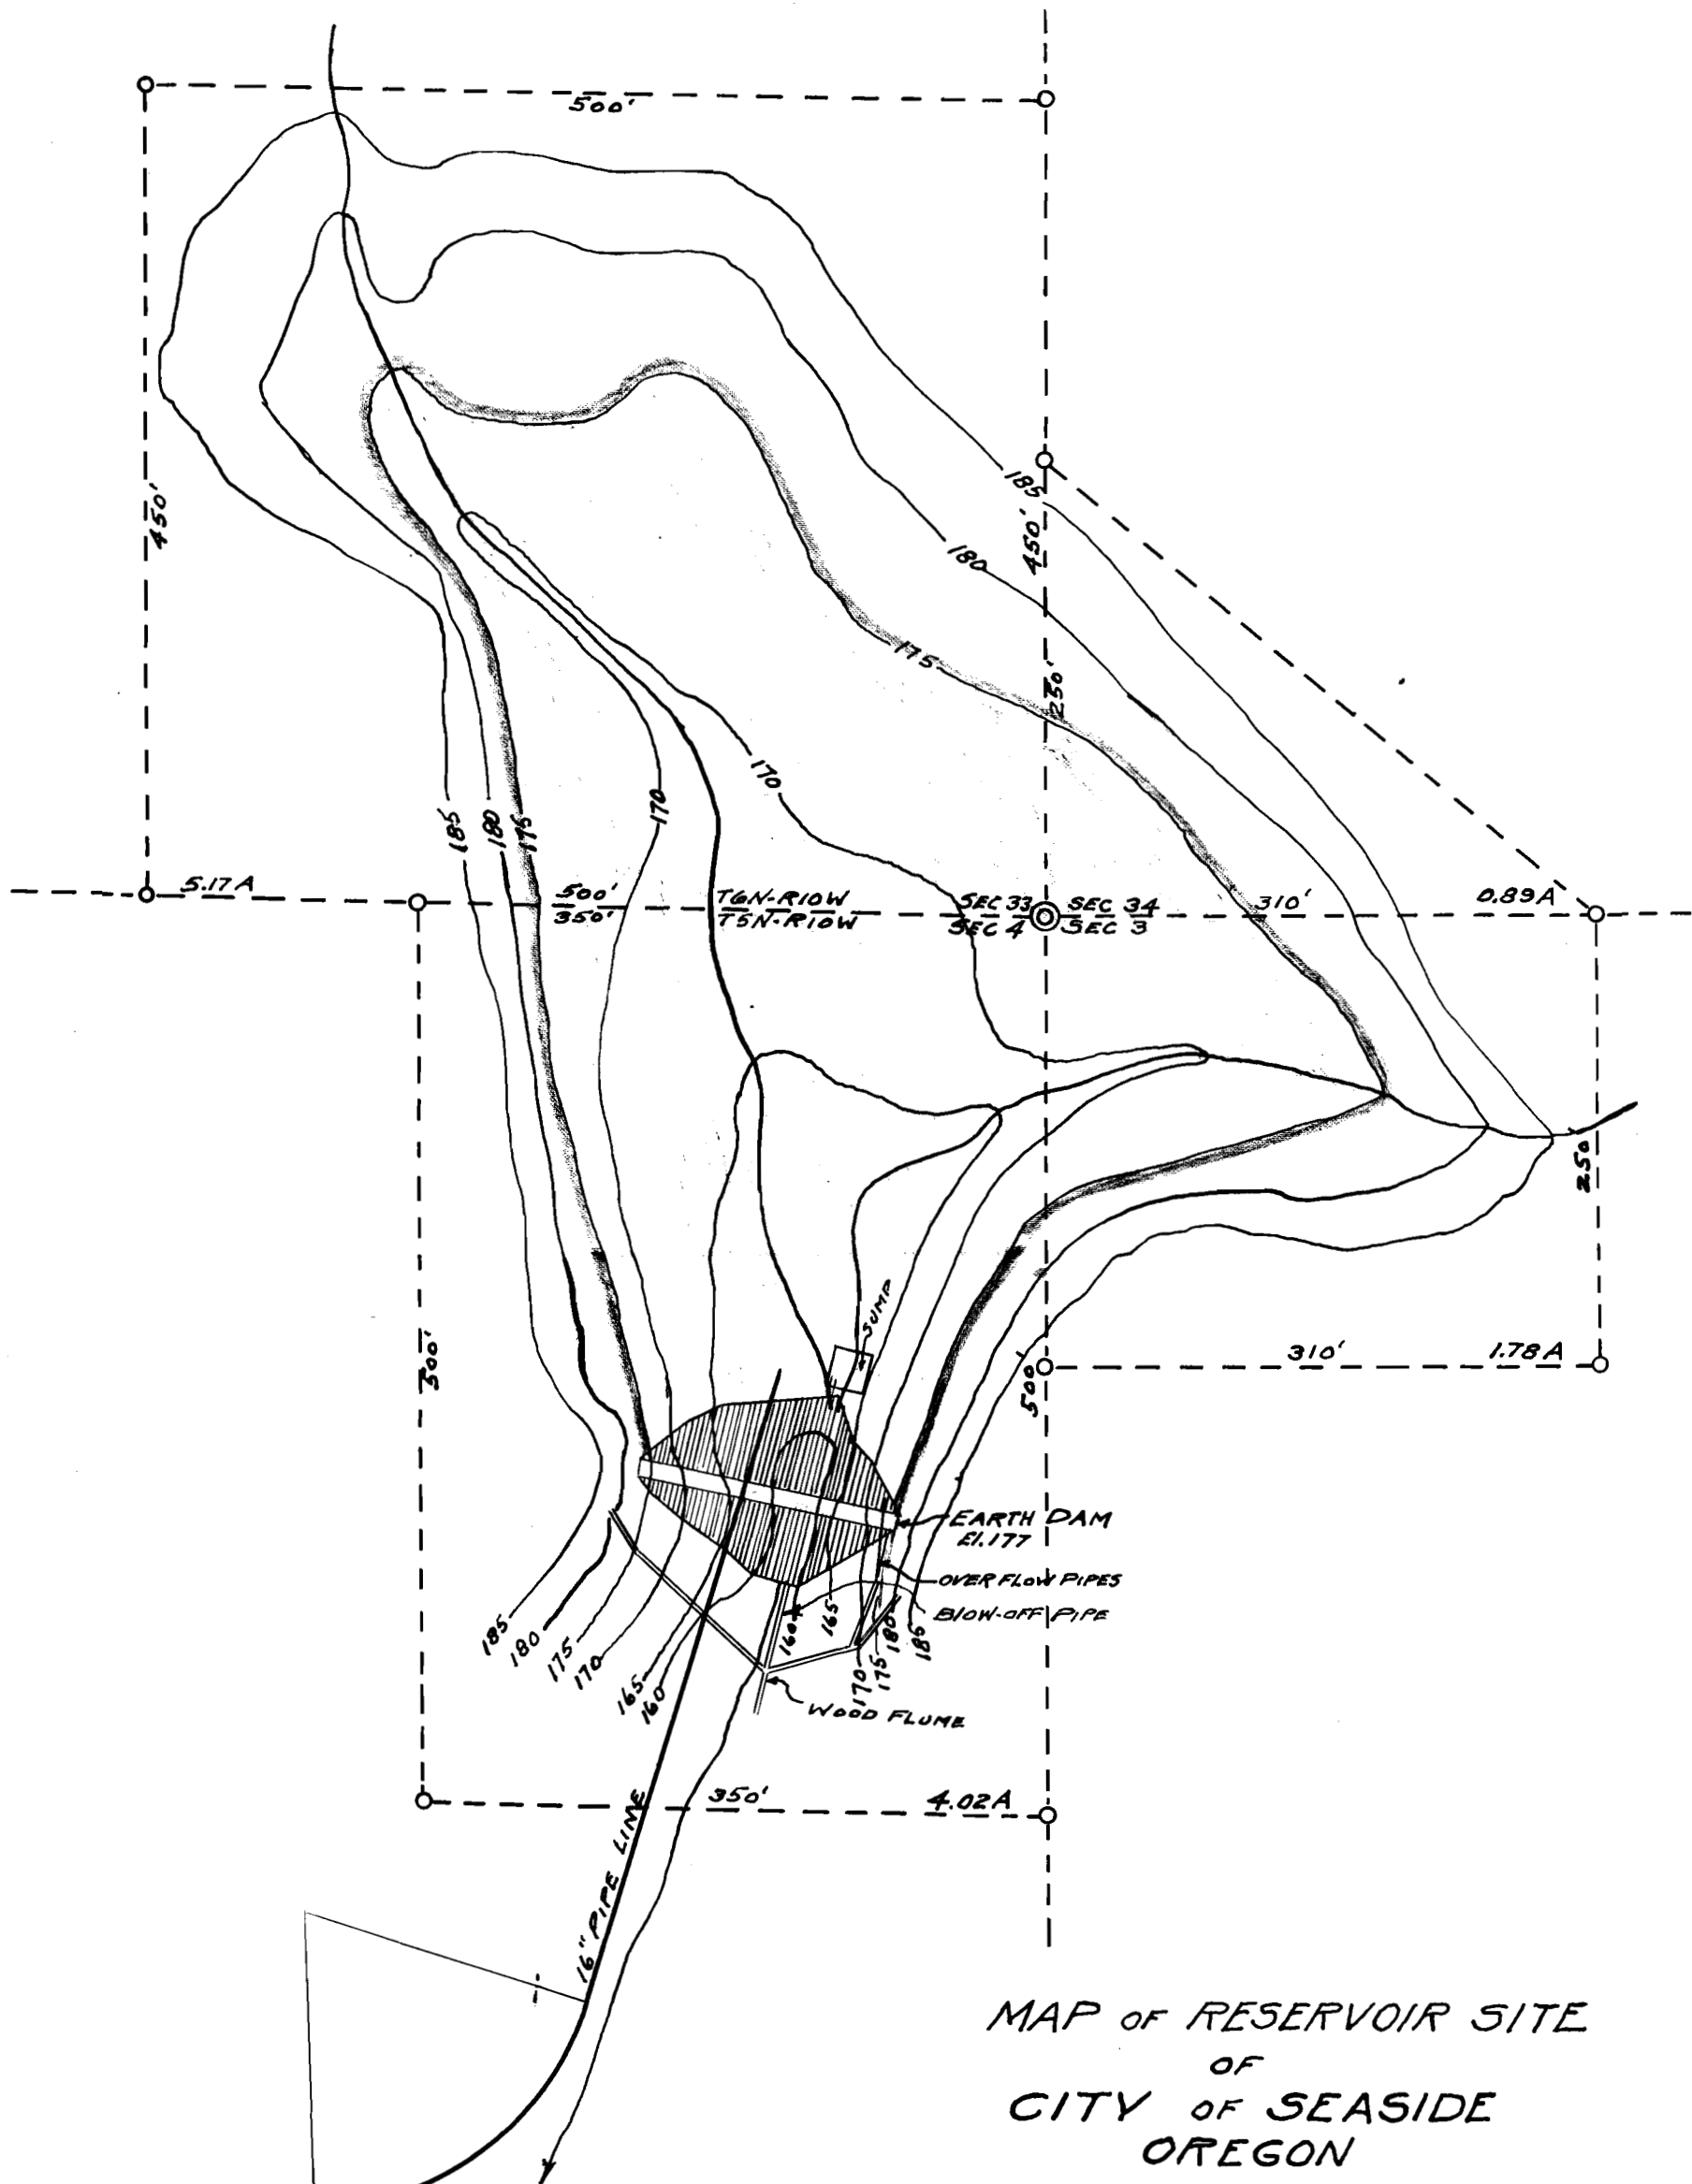

MAP OF RESERVOIR SITE
OF
CITY OF SEASIDE
OREGON

CONSTRUCTED AND IN USE SINCE 1924
DASHED LINE SHOWS BOUNDARY LINES OF
CITY OWNED PROPERTY.

SCALE 1" = 100'

