


LAFFOLLETTE & ALLEN DITCH

T 6656
2428
76674

CROOK CO.

5712
3517

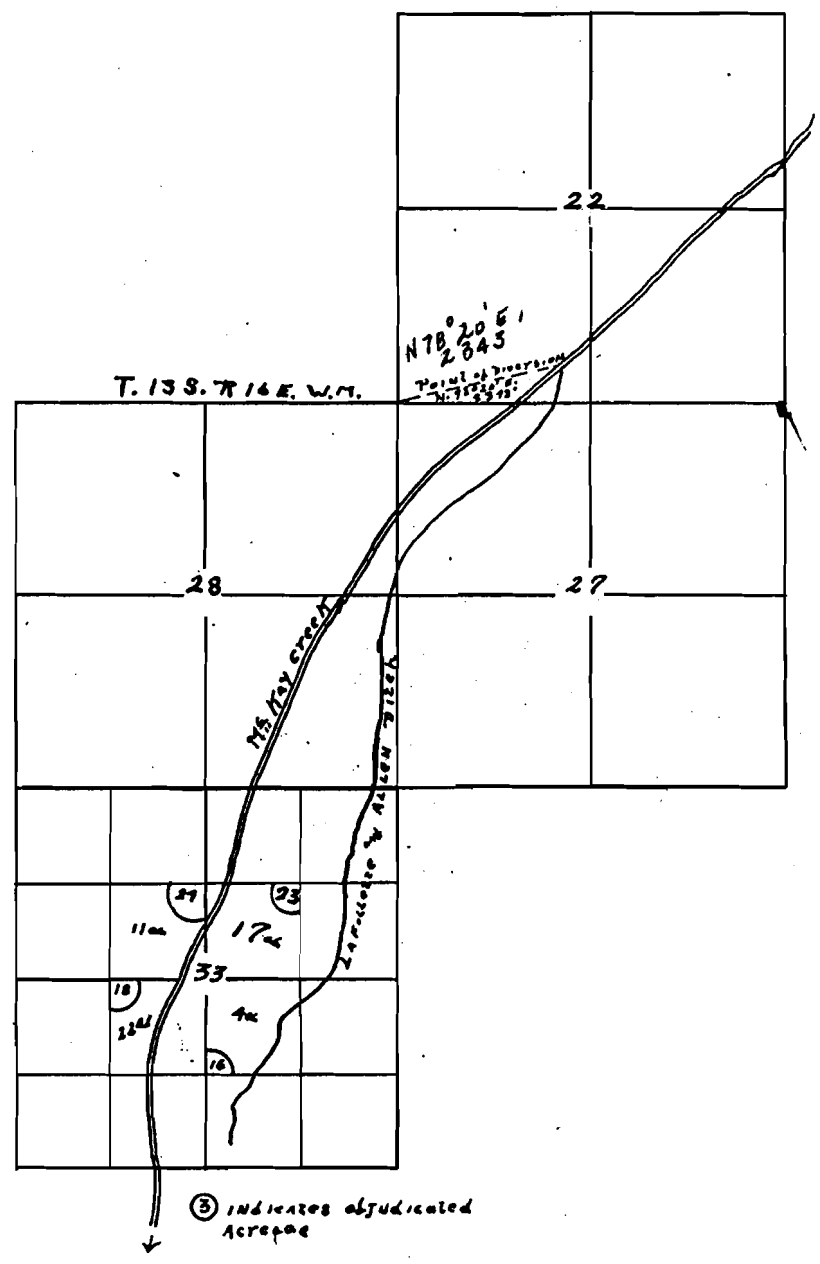

2114

5
2114