


T7SR2WWM

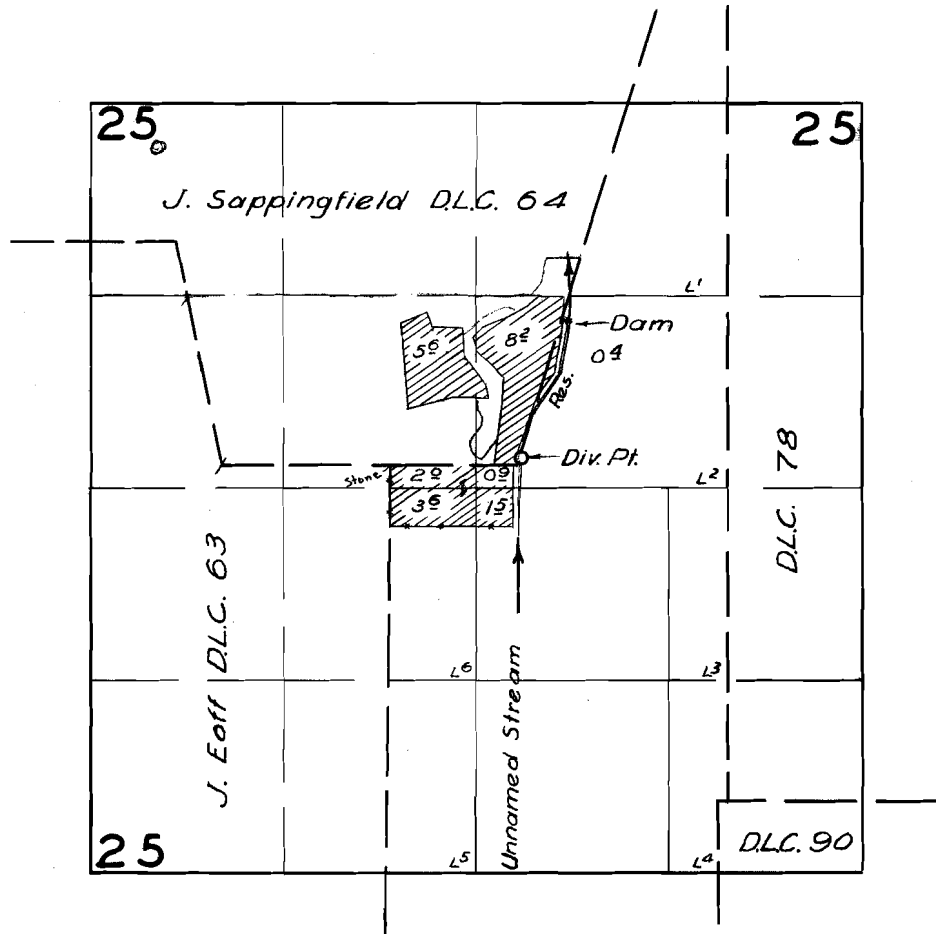

FINAL PROOF SURVEY

UNDER

R-26805

R-1321

Application No. 26806 Permit No. 21053

IN NAME OF

Chas. A. Sappingfield

Surveyed June 13 1957, by M. Bish