


T. 34 S., R. 4 W., W.M.

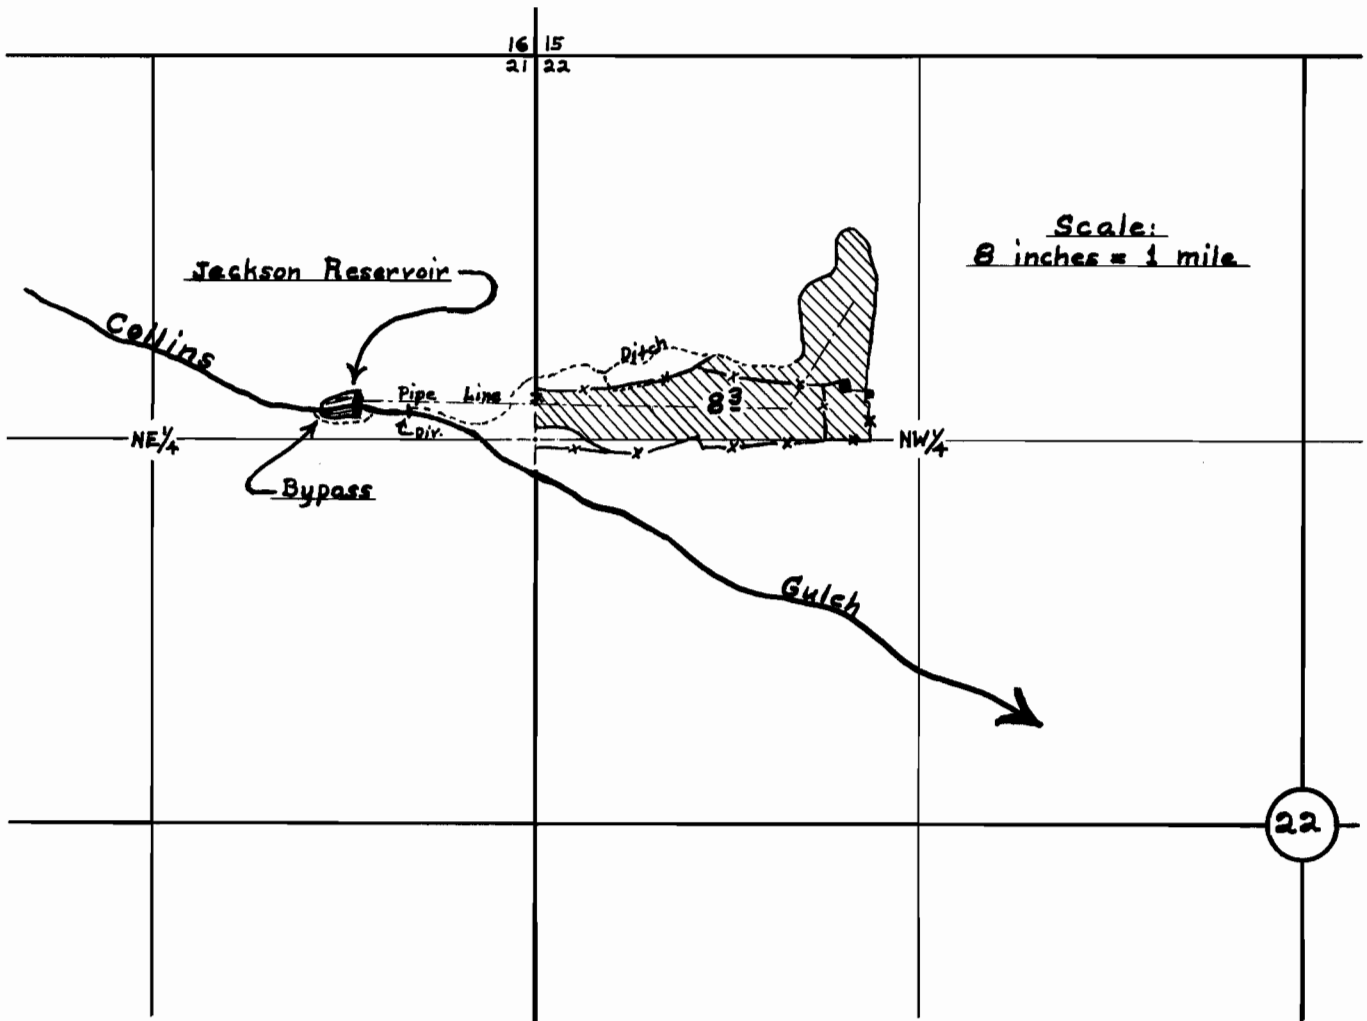

FINAL PROOF SURVEY

UNDER

R-29921

R-1742

Application No. 29922 Permit No. 23553

IN NAME OF

Chas. F. Jackson

Surveyed March 27, 1958, by D. C. Hendrix, W.M.