


T. 30S. R. 4W. W.M.

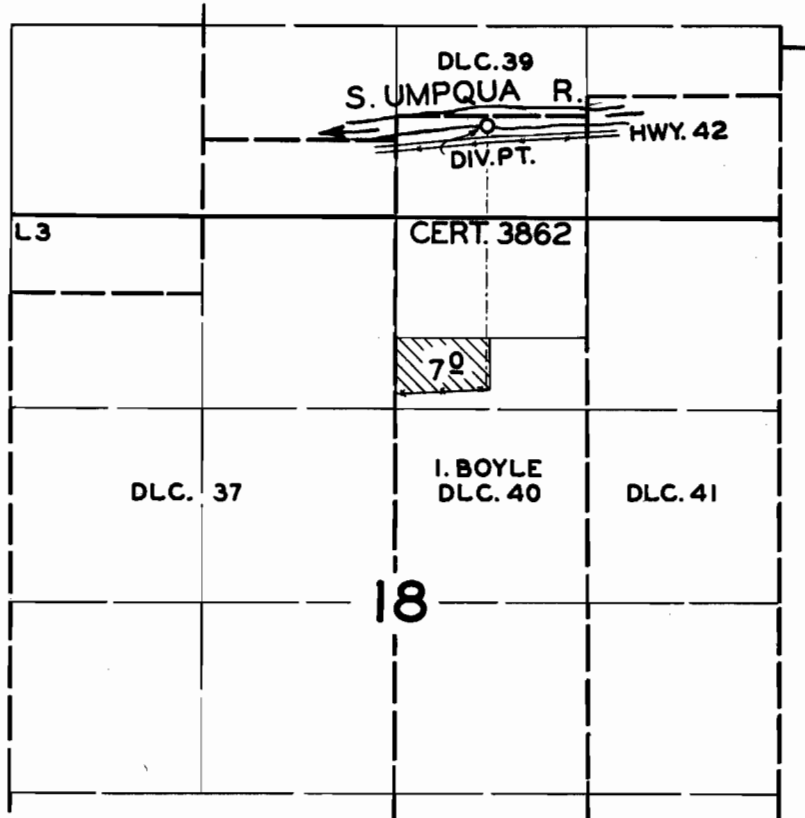

FINAL PROOF SURVEY
UNDER

Application No. 16352 Permit No. 12165
IN NAME OF

MRS. A.W. BAUM

Surveyed JULY 28 1957, by *m. Bish*