


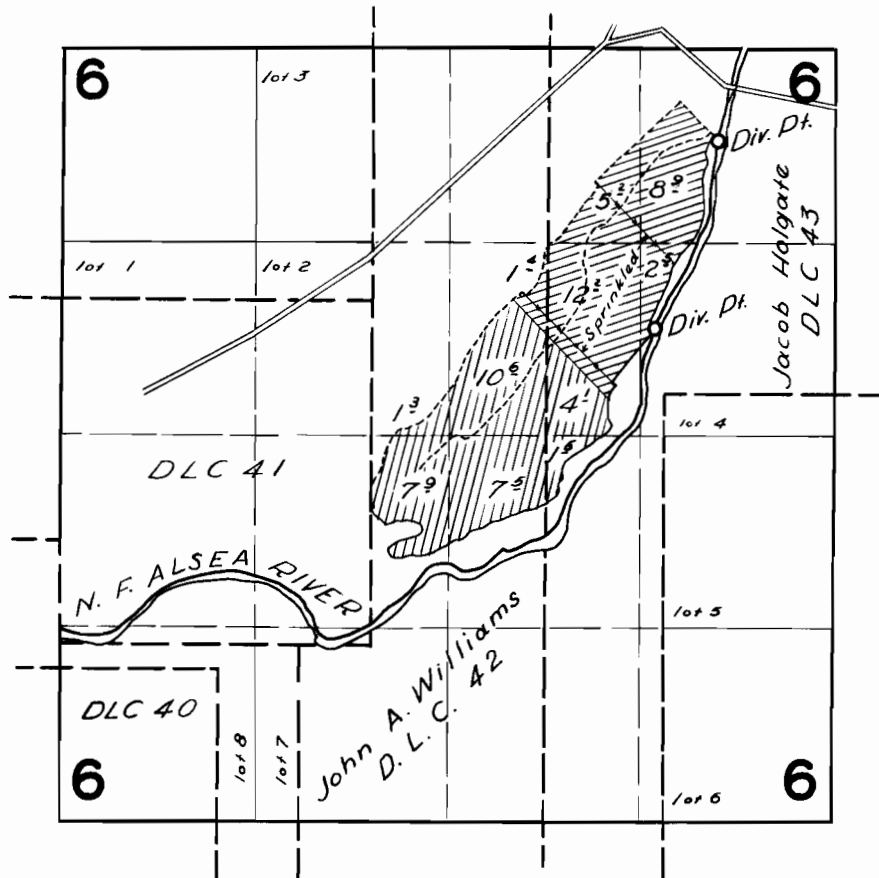

T.14S.R.7W.W.M.



**FINAL PROOF SURVEY**  
UNDER

18903                      14589      
Application No. 27309    Permit No. 21476      
IN NAME OF

*JOHN W. BUSTER & EDNA V. WHEELER*

Surveyed 23 Aug. 1957, by *P. W. Kelly*